

1993

COMMISSION

LAND CORNER RECORDATION CERTIFICATE
Filing Requirement of Act 74, Mich. P.A. 1970

PRESQUE ISLE COUNTY
RECORDED

93 DEC 22 AM 10:01

Janet M. Samb
REGISTER OF DEEDS

For corners in

<u>PRESQUE ISLE</u> (County)	Located In:	Corner Code #
1. Public Land Survey	T <u>34N</u> R <u>2E</u>	<u>A-13</u>
	T _____ R _____	_____
	T _____ R _____	_____
	T _____ R _____	_____
2. Property Controlling in Section	S _____ T _____ R _____	_____
	S _____ T _____ R _____	_____
3. Miscellaneous Property in Sec.	S _____ T _____ R _____	_____
	S _____ T _____ R _____	_____

Register of Deeds Stamp & File Number

- 4. Lot No. _____, Recorded Plat _____
- 5. Private Claims _____

	A	B	C	D	E	F	G	H	I	J	K	L	M
2	6	5	4	3	2								
3													
4	7	8	9	10	11	12							
5													
6	18	17	16	15	14	13							
7													
8	19	20	21	22	23	24							
9													
10	30	29	28	27	26	25							
11													
12	31	32	33	34	35	36							
13													

I, DELMER E. PORTER a field surveyor on DEC 9, 19 93, do hereby certify that under requirements of P.A. 74, Michigan P.A. of 1970, the corner points mentioned in lines 1 and 2 above were in conformance with regulations and rules therefore as required in the current manual of survey instructions of the United States Department of the Interior, Bureau of Land Management or by a decree of a Court of Law and/or that the corner points mentioned in lines 3, 4 and 5 above were in conformance with the rules of the Michigan Board of Land Surveyors or by a Decree of a Court of Law; established, re-established, monumented, re-monumented, recovered, found as expressed below:

NOTE: Not more than 4 corners, all in the same town and range, may be recorded on this certificate.

A. Description of original monument and accessories and/or subsequent restoration:

A-13 GLO NOTES
JULY 14, 1855
24" HEMLOCK S 26° W 35 lks.
12" HEMLOCK N 16° E 16 lks.

WITNESSES
DNR MONUMENT
5" SPRUCE S 68° W 35.3'
3" BALSAM N 36° E 2.6'

A-13
CORNER POSITION SET BY CARL JOHNSON
L.S. 30083 FROM RIVER CROSSING
(NOT RECORDED)


B. Description of corner evidence found and/or method applied in restoring or reestablishing corner:

A-13
DEC. 9, 1993
RESET POSITION FROM RECORD DISTANCE ACROSS SOUTH
LINE OF SECTION 31 AND BALSAM WITNESS TREE.
CORNER WAS REMOVED DURING FARMLAND PROJECT BY
LAND OWNER N 36° E 2.6' 3" BALSAM STUMP
SCRIBED "NBT"
SET 1/2" ROD & CAP #15410

Ratified by Peer Group
in accordance with P.A. 345
Chairman Delmer E. Porter
Date December 18, 1993

C. Description of monument for corner and accessories established to perpetuate locating the position of the corner:

A-13 1/2" ROD & CAP #15410
S 77° E 5.85' FENCE CORNER
N 40° E 27.37' RAILROAD TIE FENCE CORNER
N 73° W 160.10' 4" RED PINE
N 83° E 102.88' 12" ASPEN
* NAILS AND TAGS #15410 USED IN WITNESSES
PORTER'S SURVEY, P.C.

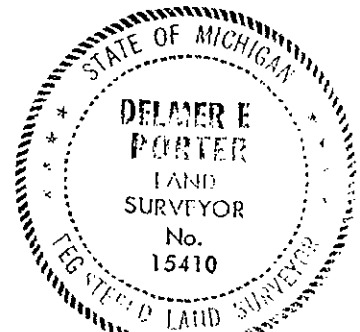

Signed by Delmer E. Porter
Surveyor's Michigan License No. 15410

Date Dec 20, 1993

