

93 DEC 20 PM 4:48

LAND CORNER RECORDATION CERTIFICATE  
Filing Requirement of Act 74, Mich. P.A. 1970

For corners in

PRESQUE ISLE  
(County)

Located In:

Corner Code #

- |                                    |                          |            |
|------------------------------------|--------------------------|------------|
| 1. Public Land Survey              | T <u>34N</u> R <u>2E</u> | <u>B-3</u> |
|                                    | T _____ R _____          | _____      |
|                                    | T _____ R _____          | _____      |
|                                    | T _____ R _____          | _____      |
| 2. Property Controlling in Section | S _____ T _____ R _____  | _____      |
|                                    | S _____ T _____ R _____  | _____      |
| 3. Miscellaneous Property in Sec.  | S _____ T _____ R _____  | _____      |
|                                    | S _____ T _____ R _____  | _____      |

*Janet M. Lamb*  
REGISTER OF DEEDS

LIBER **307** PAGE **882**

Register of Deeds Stamp & File Number

4. Lot No. \_\_\_\_\_, Recorded Plat \_\_\_\_\_
5. Private Claims \_\_\_\_\_

	A	B	C	D	E	F	G	H	I	J	K	L	M
2	6		5		4		3		2		1		
3		●											
4	7		8		9		10		11		12		
5													
6	18		17		16		15		14		13		
7													
8	19		20		21		22		23		24		
9													
10	30		29		28		27		26		25		
11													
12	31		32		33		34		35		36		
13													

I, Ronald R. Bischer, in a field survey on August 30, 19 93, do hereby certify that under requirements of P.A. 74, Michigan P.A. of 1970, the corner points mentioned in lines 1 and 2 above were in conformance with regulations and rules therefore as required in the current manual of survey instructions of the United States Department of the Interior, Bureau of Land Management or by a decree of a Court of Law and/or that the corner points mentioned in lines 3, 4 and 5 above were in conformance with the rules of the Michigan Board of Land Surveyors or by a Decree of a Court of Law; established, re-established, monumented, re-monumented, recovered, found as expressed below:


**NOTE: Not more than 4 corners, all in the same town and range, may be recorded on this certificate.**

A. Description of original monument and accessories and/or subsequent restoration:

- |                                  |   |
|----------------------------------|---|
| B-3                              | Due S 32.07' Fence Corner                         |
| July 1855 - Geo H. Cannon        | Recorded on Page 294, Land Recordation, 9/29/78.  |
| Set Wood Post                    | 1988 - Clifford C. Lindgren - found Boat spike    |
| 7" Sugar N68°E 24 links          | Set 1/2" Rod after road construction (Cap #14098) |
| 9" Sugar S15°E 15 links          | S50°E 59.45' 20" Twin Maple                       |
| 1978 - Delmar E. Porter          | S05°W 30.31' Chiseled X in top of R/W Marker      |
| Found Boat spike in Monument Box | N10°W 56.70' Telephone pole                       |
| N28°W 75.15' Power pole          | N30°W 75.12' Power pole                           |
| S53°E 59.41' 6" Maple            | Recorded on Page 761, Land Recordation, 6/22/89.  |

B. Description of corner evidence found and/or method applied in restoring or reestablishing corner:

- |                             |   |                                     |
|-----------------------------|---|-------------------------------------|
| B-3                         | Found 1/2" Rod and Cap #14098 in Monument Box | <b>SURVEY &amp; REMONUMENTATION</b> |
| S55°E 59.45' 20" Twin Maple |   |                                     |
| South 32.07' Fence corner   |   |                                     |
| N33°W 75.12' Power pole     |   |                                     |
| N13°W 56.70' Telephone pole |   |                                     |
|                             |   | <b>1993</b>                         |
|                             |   | <b>COMMISSION</b>                   |

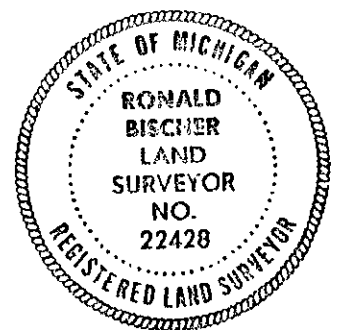

C. Description of monument for corner and accessories established to perpetuate locating the position of the corner:

- B-3  
1/2" Rod and Cap #14098 in Monument Box  
S55°E 59.45' 20" Twin Maple  
South 32.07' Fence corner  
N33°W 75.12' Power pole  
N13°W 56.70' Telephone pole

Ratified by Peer Group  
in accordance with P.A. 345  
Chairman *Delmar E. Porter*  
Date December 7, 1993

\*Witness tags and nails used.

Signed by Ronald R. Bischer  
Surveyor's Michigan License No. 22428

Date 12-13-93

## CORNER HISTORY RESEARCH SHEET

LIBER 307 PAGE 883

B-3 Corner, Section 6, 17, Township 34N Range 2E

<u>Activity</u>	<u>Monument &amp; Accessories</u>	<u>Notes</u>
1855 Resurvey Geo. H. Cannon	Set Wood Post 7" Sugar N68°E 24 links 9" Sugar S15°E 15 links	
1978 Delmar E. Porter #15410	Found Boat spike in MSHD monument box Set three witnesses Recorded on Page 294, Land Recordation, September 29, 1978	
1988 Clifford C. Lindgren #14098	Found Boat spike Set ½" Rod in Monument box after road construction Set 4 witnesses Recorded on Page 761, Land Recordation, June 22, 1989	
1993 Remonumentation Ronald R. Bischer #22428	Found ½" Rod & cap #14098 in monument box S55°E 59.45' 20" Twin maple found nail w/MSHD tag South 32.07' Fence corner found nail w/tag #15410 N33°W 75.12' Power pole found nail w/tag #14098 N13°W 56.70' Telephone pole found nail w/tag #15410	

#3