

1993

PRESQUE ISLE COUNTY
RECORDED

93 DEC 22 AM 10:01

COMMISSION

LAND CORNER RECORDATION CERTIFICATE
Filing Requirement of Act 74, Mich. P.A. 1970

Janet M. Lamb
REGISTER OF DEEDS

For corners in

<u>PRESQUE ISLE</u> (County)	Located In:	Corner Code ##
1. Public Land Survey	T <u>34</u> N R <u>2E</u>	<u>B-7</u>
	T _____ R _____	_____
	T _____ R _____	_____
	T _____ R _____	_____
2. Property Controlling in Section	S _____ T _____ R _____	_____
	S _____ T _____ R _____	_____
3. Miscellaneous Property in Sec.	S _____ T _____ R _____	_____
	S _____ T _____ R _____	_____

Register of Deeds Stamp & File Number

- 4. Lot No. _____, Recorded Plat _____
- 5. Private Claims _____

I, DELMER E. PORTER field survey on SEPT. 8, 1993
do hereby certify that under requirements of P.A. 74, Michigan P.A. of 1970, the corner points mentioned in lines 1 and 2 above were in conformance with regulations and rules therefore as required in the current manual of survey instructions of the United States Department of the Interior, Bureau of Land Management or by a decree of a Court of Law and/or that the corner points mentioned in lines 3, 4 and 5 above were in conformance with the rules of the Michigan Board of Land Surveyors or by a Decree of a Court of Law; established, re-established, monumented, re-monumented, recovered, found as expressed below:

NOTE: Not more than 4 corners, all in the same town and range, may be recorded on this certificate.

	A	B	C	D	E	F	G	H	I	J	K	L	M
2	6		5		4		3		2		1		
3													
4	7		8		9		10		11		12		
5													
6	18		17		16		15		14		13		
7													
8	19		20		21		22		23		24		
9													
10	30		29		28		27		26		25		
11													
12	31		32		33		34		35		36		
13													

A. Description of original monument and accessories and/or subsequent restoration:

B-7 GLO NOTES
JULY 19, 1855
WHITE PINE 10" N 20° E 17 lks.
ELM 6" N 40° W 9 lks.

WITNESSES
N 08° W 11.96' 33" ELM
S 76° E 171.48' 14" CHERRY
S 02° W 128.05' T. POLE

B-7
P.A. 74 FILING BY DELMER E. PORTER
L.S. 15410 PAGE 410 LAND CORNER RECORDS
FOUND 1" PINE AND REPLACED WITH
4" CONCRETE MONUMENT WITH BRASS CAP


B. Description of corner evidence found and/or method applied in restoring or reestablishing corner:

B-7
FOUND 4" CONCRETE MONUMENT WITH 3/8" ROD
(BRASS CAP MISSING)
N 08° W 11.53' 40" ELM
S 77° E 171.75' 16" CHERRY

Ratified by Peer Group
in accordance with P.A. 345
Chairman *Delmer E. Porter*
Date December 18, 1993

C. Description of monument for corner and accessories established to perpetuate locating the position of the corner:

B-7
4" CONCRETE MONUMENT WITH 3/8" ROD
N 08° W 11.53' 40" ELM
S 77° E 171.75' 16" CHERRY
S 20° W 78.14' 5" ASPEN
S 57° W 102.03' 5" ASPEN
* NAILS & TAGS #15410 USED IN WITNESSES
PORTER'S SURVEY, P.C.

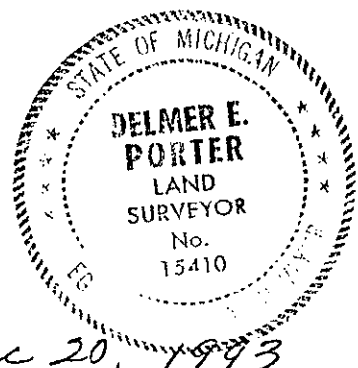

Signed by *Delmer E. Porter*

Date Dec 20, 1993

Surveyor's Michigan License No. 15410

CORNER HISTORY RESEARCH SHEET

B-7

T34N,R2E ALLIS TOWNSHIP-NORTH PART,
PRESQUE ISLE COUNTY, MICHIGAN.

ACTIVITY MONUMENT & ACCESSORIES - COMMENTS

GLO Survey
July 19, 1855
White Pine 10" N20°E 17 Links
Elm 6" N40°W 9 Links

Act 132 survey by
Delmer E Porter #15410
Recorded, Oct. 16, 1976
SUR#69-78 File#34R2094
Liber 226, Page 185
FD. 1" Pipe
N08°W 11.96' 30" Elm
S01°W 26.64' FE Cor.

Act 74 filing by
Delmer E Porter #15410
Nov. 9, 1976, Page 410
Corner Recordation
Found 1" Pipe
N08°W 11.96 33" Elm
Replaced with P.I. Remon.
Conc. Mon. & Brass Cap
N08°W 11.96' 33" Elm
S76°E 171.48' 14" Cherry
S02°W 128.05' T. Pole

Act 132 Survey by
Delmer E. Porter #15410
April 25, 1980 Not Recorded
SUR#182-79 File#34R2109
Same as above

Act 132 Survey by
Delmer E. Porter #15410
June 1, 1990, Not Recorded
SUR#40-90 File#34R2181
FD. Conc. Mon & Brass Cap
S01°W 26.64' FE Post
N08°W 11.96' 30" Elm
N45°E 33.97' FE Post

Mortgage Report by
Delmer E. Porter #15410
Aug. 15, 1990, Not Recorded
SUR#84-90 File#34R2240-M
Same as above

Act 132 survey by
Delmer E. Porter #15410
June 12, 1992, Not Recorded.
SUR#67-92 File#34R2263
FD. Conc. Mon. & Brass Cap
N08°W 10.55' 33" Elm
S76°E 171.43' 14" Cherry
S02°W 128.05' P. Pole

Remonumentation
Sept. 8, 1993.
FD. Conc. Mon. with 3/8" Rod
N08°W 11.53' 40" Elm
S77°E 171.75' 16" Cherry
Left Same
N08°W 11.53' 40" Elm
S77°E 171.75' 16" Cherry
S20°W 78.14' 5" Aspen
S57°W 102.03' 5" Aspen

2