

COMMISSION

LAND CORNER RECORDATION CERTIFICATE  
Filing Requirement of Act 74, Mich. P.A. 1970

PRESQUE ISLE COUNTY  
RECORDED

93 DEC 22 AM 10:01

*Janet M. Lamb*  
REGISTER OF DEEDS

For corners in

<u>PRESQUE ISLE</u> (County)	Located In:	Corner Code =#
1. Public Land Survey	T <u>34N</u> <u>2E</u>	<u>B-9</u>
	T _____ R _____	_____
	T _____ R _____	_____
	T _____ R _____	_____
2. Property Controlling in Section	S _____ T _____ R _____	_____
	S _____ T _____ R _____	_____
3. Miscellaneous Property in Sec.	S _____ T _____ R _____	_____
	S _____ T _____ R _____	_____

Register of Deeds Stamp & File Number

4. Lot No. \_\_\_\_\_, Recorded Plat \_\_\_\_\_  
5. Private Claims \_\_\_\_\_

I, DELMER E. PORTER, field survey on SEPT. 11, 19 93, do hereby certify that under requirements of P.A. 74, Michigan P.A. of 1970, the corner points mentioned in lines 1 and 2 above were in conformance with regulations and rules therefore as required in the current manual of survey instructions of the United States Department of the Interior, Bureau of Land Management or by a decree of a Court of Law and/or that the corner points mentioned in lines 3, 4 and 5 above were in conformance with the rules of the Michigan Board of Land Surveyors or by a Decree of a Court of Law; established, re-established, monumented, re-monumented, recovered, found as expressed below:

	A	B	C	D	E	F	G	H	I	J	K	L	M
2	6	5	4	3	2								
3													
4	7	8	9	10	11	12							
5													
6	18	17	16	15	14	13							
7													
8	19	20	21	22	23	24							
9	●												
10	30	29	28	27	26	25							
11													
12	31	32	33	34	35	36							
13													

NOTE: Not more than 4 corners, all in the same town and range, may be recorded on this certificate.

A. Description of original monument and accessories and/or subsequent restoration:

B-9  
GLO NOTES  
JULY 18, 1855  
LYNN 11" S 30° W 211ks.  
LYNN 9" N 52° E 13 1/2 lks.

B-9  
DEC. 18, 1977  
P.A. 74 BY RONALD R. BISCHER  
RECORDED PG. 209, LAND CORNER  
RECORDS. FOUND  
4" DRIVE SHA FT HOUSING  
NORTH 19.96' 4" ELM  
S 01° W 53.65' 18" ELM

B. Description of corner evidence found and/or method applied in restoring or reestablishing corner: N 68°E 46.76' 11" ELM


B-9  
SEPT. 11, 1993  
FOUND 4" AXLE SHAFT HOUSING  
N 01° E 19.90' 6" LEM

Ratified by Peer Group  
in accordance with P.A. 345

Chairman *Delmer E. Porter*  
Date December 14, 1993

C. Description of monument for corner and accessories established to perpetuate locating the position of the corner:

B-9  
4" AXLE SHAFT HOUSING  
N 01° E 19.90' 6" ELM  
S 23° E 61.34' 10" ASH  
S 02° W 61.54' 5" RED PINE  
N 31° W 120.53' 4" TWIN RED PINE  
\* NAILS AND TAGS #15410 USED ON WITNESSES  
PORTER'S SURVEY, P.C.

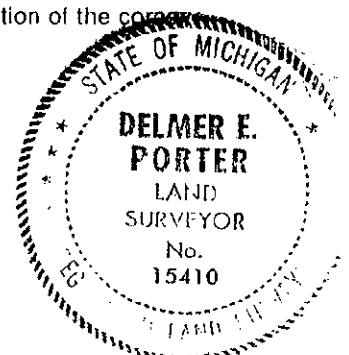

Signed by *Delmer E. Porter*

Date Dec 20, 1993

Surveyor's Michigan License No. 15410

# CORNER HISTORY RESEARCH SHEET

B-9

T34N,R2E ALLIS TOWNSHIP-NORTH PART,  
PRESQUE ISLE COUNTY, MICHIGAN.

## ACTIVITY                      MONUMENT & ACCESSORIES                      -                      COMMENTS

GLO Survey  
July 18, 1855

Lynn 11" S30°W 21 Links  
Lynn 9" N52°E 13 1/2 Links

Corner by :  
Lyle Schmalzried  
MDSH, July 1961

Fd. 4" Drive Shaft Housing  
6" Below surface  
S01°W 53.65' 17" Elm  
S26°E 61.52' 10" Ash  
N68°E 46.76' 11" Elm

Corner used by:  
Porter's Survey  
June 10, 1972

Same Witnesses as above  
Fd. 5 1/2' North of Road  
Centerline in line with  
Fence North & South

Act 74 filing by:  
Ronald R. Bischer  
#22428, Dec.18, 1977,  
Page 209, Corner  
Recordation

Fd. 4" Drive Shaft Housing  
& 2 Witnesses by Lyle  
Schmalzried MDSH - 1961  
Left Same  
North 19.96' 4" Elm  
S01°W 53.65' 18" Elm  
N68°E 46.76' 11" Elm

Act 132 Survey by:  
Porter's Survey  
Nov.23, 1977,  
Survey#161-77  
File#34R2091  
Unrecorded

4" Axle Shaft Housing  
North 19.96' 4" Elm  
S01°W 53.65' 18" Elm

Act 132 filing by:  
Porter's Survey  
June 20, 1979,  
Survey#41-79  
File#34R2105

4" Axle Shaft Housing  
North 19.96' 4" Elm  
N68°E 46.76' 11" Elm  
S01°W 53.65' 18" Elm

Remonumentation  
Sept.11, 1993

Fd. 4" Axle Housing  
N01°E 19.90' 6" Elm  
Left Same  
N01°E 19.90' 6" Elm  
S23°E 61.34' 10" Ash  
S02°W 61.54' 5" R. Pine  
N31°W 120.53' 4" Tw. R. Pine

CONVEY &  
REMONUMENTATION

JAN 22 2001

SECTION