

93 DEC 20 PM 4:48

LAND CORNER RECORDATION CERTIFICATE
Filing Requirement of Act 74, Mich. P.A. 1970

Janet M. Lamb
REGISTER OF DEEDS

For corners in

<u>PRESQUE ISLE</u> <small>(County)</small>	Located In:	Corner Code #
1. Public Land Survey	T <u>34N</u> R <u>2E</u>	<u>C-1</u>
	T _____ R _____	_____
	T _____ R _____	_____
	T _____ R _____	_____
2. Property Controlling in Section	S _____ T _____ R _____	_____
	S _____ T _____ R _____	_____
3. Miscellaneous Property in Sec.	S _____ T _____ R _____	_____
	S _____ T _____ R _____	_____

LIBER **307** PAGE **886**

Register of Deeds Stamp & File Number

4. Lot No. _____, Recorded Plat _____
5. Private Claims _____

	A	B	C	D	E	F	G	H	I	J	K	L
2	6		5		4		3		2		1	
3												
4	7		8		9		10		11		12	
5												
6	18		17		16		15		14		13	
7												
8	19		20		21		22		23		24	
9												
10	30		29		28		27		26		25	
11												
12	31		32		33		34		35		36	
13												

I, Ronald R. Bischer, in a field survey on August 30, 19 93, do hereby certify that under requirements of P.A. 74, Michigan P.A. of 1970, the corner points mentioned in lines 1 and 2 above were in conformance with regulations and rules therefore as required in the current manual of survey instructions of the United States Department of the Interior, Bureau of Land Management or by a decree of a Court of Law and/or that the corner points mentioned in lines 3, 4 and 5 above were in conformance with the rules of the Michigan Board of Land Surveyors or by a Decree of a Court of Law; established, re-established, monumented, re-monumented, recovered, found as expressed below:

NOTE: Not more than 4 corners, all in the same town and range, may be recorded on this certificate.

A. Description of original monument and accessories and/or subsequent restoration:

C-1
July 1855 - Geo. H. Cannon
Set Wood Post
9" Cedar S42°E 37.5 links
12" Cedar S75°W 9.5 links
1973 - Delmar E. Porter
Set 1/2" Rod by single proportion meas.
between the SE Cor. & SW Cor. of Sec.
31, T35N, R2E.

S70°E 93.29' Power pole
S05°W 122.22' 11" Tamarack
S35°W 84.35' 11" Cedar
Recorded on Page 27, Land Recordation, 10/12/78.
1978 - Delmar E. Porter (Remonumentation)
Replaced 1/2" Rod with Conc. Monument w/Brass Cap.
Used 1973 Porter witnesses.
Recorded on Page 375, Land Recordation,
11/29/78.


B. Description of corner evidence found and/or method applied in restoring or reestablishing corner:

C-1
Found Presque Isle County Remonumentation Monument
S78°E 93.29' Power pole
S05°W 122.22' 11" Tamarack
S35°W 84.23' 11" Cedar

SURVEY &
REMONUMENTATION

1993

COMMISSION

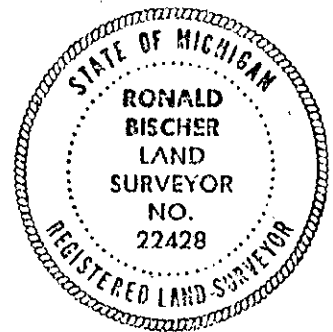

C. Description of monument for corner and accessories established to perpetuate locating the position of the corner:

C-1
Presque Isle County Remonumentation Monument
S78°E 93.29' Power pole
S05°W 122.22' 11" Tamarack
S35°W 84.23' 11" Cedar
N22°W 18.53' 3" Cedar

Ratified by Peer Group
in accordance with P.A. 345
Chairman *Delmar E. Porter*
Date December 7, 1993

*Witness tags and nails used.

Signed by Ronald R. Bischer
Surveyor's Michigan License No. 22428

Date 12-13-93

C-1 Corner, Section 5, 6, Township 34N Range 2E

<u>Activity</u>	<u>Monument & Accessories</u>	<u>Notes</u>
1855 Resurvey Geo. H. Cannon	Set Wood Post 9" Cedar S42°E 37.5 links 12" Cedar S75°W 9.5 links	
1973 Delmar E. Porter #15410	Set ½" Rod by Single Proportion measurement between the SE Cor. & SW Cor. of Sec. 31, T35N, R2E. Set three witnesses Recorded on Page 27, Land Recordation, October 12, 1973	
1978 Remonumentation Delmar E. Porter #15410	Set Concrete monument w/brass cap Found and used previously recorded witnesses. Recorded on Page 375, Land Recordation, November 29, 1978	
1993 Remonumentation Ronald R. Bischer #22428	Found Concrete monument w/brass cap S78°E 93.29' Power pole found nail w/tag #15410 S05°W 122.22' 11" Tamarack found nail w/tag #15410 S35°W 84.23' 11" Cedar found nail w/tag #15410 N22°W 18.53' 3" Cedar set nail w/tag #22428	

5