

93 DEC 20 PM 4:48

LAND CORNER RECORDATION CERTIFICATE
Filing Requirement of Act 74, Mich. P.A. 1970

Gene M. Lamb
REGISTER OF DEEDS

For corners in

<u>PRESQUE ISLE</u> (County)	Located In:	Corner Code #
1. Public Land Survey	T <u>34N</u> R <u>2E</u>	<u>C-2</u>
	T _____ R _____	_____
	T _____ R _____	_____
	T _____ R _____	_____
2. Property Controlling in Section	S _____ T _____ R _____	_____
	S _____ T _____ R _____	_____
3. Miscellaneous Property in Sec.	S _____ T _____ R _____	_____
	S _____ T _____ R _____	_____

LIBER 307 PAGE 888

Register of Deeds Stamp & File Number

4. Lot No. _____; Recorded Plat _____
5. Private Claims _____

	A	B	C	D	E	F	G	H	I	J	K	L
2	6	•	5		4		3		2		1	
3												
4	7		8		9		10		11		12	
5												
6	18		17		16		15		14		13	
7												
8	19		20		21		22		23		24	
9												
10	30		29		28		27		26		25	
11												
12	31		32		33		34		35		36	
13												

I, Ronald R. Bischer, in a field survey on September 3, 19 93, do hereby certify that under requirements of P.A. 74, Michigan P.A. of 1970, the corner points mentioned in lines 1 and 2 above were in conformance with regulations and rules therefore as required in the current manual of survey instructions of the United States Department of the Interior, Bureau of Land Management or by a decree of a Court of Law and/or that the corner points mentioned in lines 3, 4 and 5 above were in conformance with the rules of the Michigan Board of Land Surveyors or by a Decree of a Court of Law; established, re-established, monumented, re-monumented, recovered, found as expressed below:

NOTE: Not more than 4 corners, all in the same town and range, may be recorded on this certificate.

A. Description of original monument and accessories and/or subsequent restoration:

C-2
July 1855
Geo. H. Cannon set Wood Post
9" Hemlock N35°E 14 links
9" Hemlock S15°W 8 links
1973 - Delmar E. Porter
Found 6" Casing w/spike, raised spike w/½" Rod & Cap #15410
Due E 31.43' Fence post
Due S 17.12' 3" Apple tree
Recorded on Page 27, Land Recordation, October 12, 1973.


B. Description of corner evidence found and/or method applied in restoring or reestablishing corner:

C-2
Found ½" Rod and cap #15410 in 6" casing.
S88°E 30.21' Fence Post
S10°E 17.12' 4" Black Cherry Tree

SURVEY &
REMONUMENTATION

1993

COMMISSION

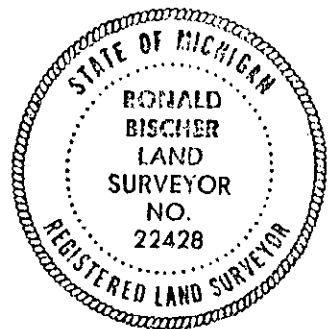

C. Description of monument for corner and accessories established to perpetuate locating the position of the corner:

C-2
½" Rod and Cap #15410 in 6" casing
S88°E 30.21' Fence post
S10°E 17.12' 4" Black Cherry tree
S51°E 26.74' 4" Black Cherry tree
N02°E 49.85' 3" Black Cherry tree

*Witness tags and nails used.

Ratified by Peer Group
in accordance with P.A. 345

Chairman *Delmar E. Porter*

Date December 7, 1993

Signed by Ronald R. Bischer

Date 12-13-93

Surveyor's Michigan License No. 22428

C-2 Corner, Section 5, 6, Township 34N Range 2E

<u>Activity</u>	<u>Monument & Accessories</u>	<u>Notes</u>
1855 Resurvey Geo. H. Cannon	Set Wood Post 9" Hemlock N35E 14 links 9" Hemlock S15W 8 links	
1973 Delmar E. Porter #15410	Found 6" Casing w/spike raised w/1/2" rod & cap #15410 Set two witnesses Recorded on Page 27, Land Recordation, October 12, 1973	
1993 Remonumentation Ronald R. Bischer #22428	Found 1/2" rod & cap #15410 in 6" casing S88°E 30.21' Fence post found nail w/tag #15410 S10°E 17.12' 4" Black cherry tree found nail w/tag #15410 S51°E 26.74' 4" Black cherry tree set nail w/tag #22428 N02°E 49.85' 3" Black cherry tree set nail w/tag #22428	

3