

93 DEC 20 PM 4:48

LAND CORNER RECORDATION CERTIFICATE
Filing Requirement of Act 74, Mich. P.A. 1970

J. M. Lamb
REGISTER OF DEEDS

For corners in
PRESQUE ISLE
(County)

Located In: Corner Code #

1. Public Land Survey	T	<u>34N</u>	R	<u>2E</u>	<u>C-3</u>
	T	_____	R	_____	_____
	T	_____	R	_____	_____
	T	_____	R	_____	_____
2. Property Controlling in Section	S	_____	T	_____	_____
	S	_____	T	_____	_____
3. Miscellaneous Property in Sec.	S	_____	T	_____	_____
	S	_____	T	_____	_____

LIBER **307** PAGE **890**

Register of Deeds Stamp & File Number

4. Lot No. _____, Recorded Plat _____
5. Private Claims _____

A	B	C	D	E	F	G	H	I	J	K	L
2	6	5	4	3	2	1					
3		●									
4	7	8	9	10	11	12					
5											
6	18	17	16	15	14	13					
7											
8	19	20	21	22	23	24					
9											
10	30	29	28	27	26	25					
11											
12	31	32	33	34	35	36					
13											

I, Ronald R. Bischer, in a field survey on September 3, 19 93, do hereby certify that under requirements of P.A. 74, Michigan P.A. of 1970, the corner points mentioned in lines 1 and 2 above were in conformance with regulations and rules therefore as required in the current manual of survey instructions of the United States Department of the Interior, Bureau of Land Management or by a decree of a Court of Law and/or that the corner points mentioned in lines 3, 4 and 5 above were in conformance with the rules of the Michigan Board of Land Surveyors or by a Decree of a Court of Law; established, re-established, monumented, re-monumented, recovered, found as expressed below:

NOTE: Not more than 4 corners, all in the same town and range, may be recorded on this certificate.

A. Description of original monument and accessories and/or subsequent restoration:

C-3
 July 1855 S32°E 74.15' NE Cor of house
 Geo. H. Cannon set Wood Post 1973 - Delmar E. Porter
 13" Sugar N35°E 61 links Found 1/2" Rod in Monument Box
 14" Beech S39°W 13 links N45°W 95.80' SE Cor of store
 1955 - Michigan State Highway Dept. N60°E 49.50' Top of fire hydrant
 Set 1" Bar S55°W 47.00' North Bolt in sign base
 S37°W 49.17' Power pole Recorded on Page 26, Land
 S16°E 78.87' 6" Apple tree Recordation, October 12, 1973.


B. Description of corner evidence found and/or method applied in restoring or reestablishing corner:

C-3
 Found 1/2" Rod in Monument Box
 N76°E 49.35' Top of fire hydrant
 S36°W 49.19' Power pole
 Set cap #22428 on 1/2" Rod.

SURVEY &
REMONUMENTATION

1993

COMMISSION

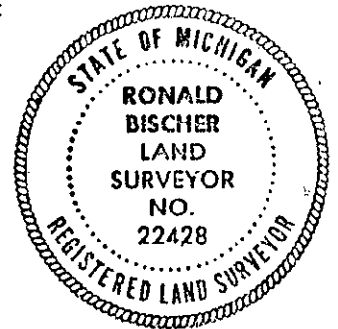

C. Description of monument for corner and accessories established to perpetuate locating the position of the corner:

C-3
 1/2" Rod and Cap #22428 in Monument Box
 N76°E 49.35' Top of Fire Hydrant
 S36°W 49.19' Power pole
 S21°E 89.10' Telephone pole
 N41°W 88.61' SE Corner of Store

Ratified by Peer Group
in accordance with P.A. 345

Chairman Delmar E. Porter

Date December 7, 1993

*Witness tags and nails used.

Signed by Ronald R. Bischer

Date 12-13-93

Surveyor's Michigan License No. 22428

C-3 Corner, Section 5, 6, 7&8, Township 34N Range 2E

<u>Activity</u>	<u>Monument & Accessories</u>	<u>Notes</u>
1855 Resurvey Geo. H. Cannon	Set Wood Post 13" Sugar N35°E 61 links 14" Beech S39°W 13 links	
1955 MSHD	Set 1" Bar Set three witnesses	
1973 Delmar E. Porter #15410	Found ½" Rod in monument box Set three witnesses Recorded on Page 26, Land Recordation, October 12, 1973	
1993 Remonumentation Ronald R. Bischer #22428	Found ½" Rod in monument box N76°E 49.35' Top of fire hydrant appears to be same witness recorded in 1973 S36°W 49.19' Power pole found nail w/MSHD tag S21°E 89.10' Telephone pole set nail w/tag #22428 N41°W 88.61' SE Cor of Store	

#3,