

1993

COMMISSION

LAND CORNER RECORDATION CERTIFICATE

Filing Requirement of Act 74, Mich. P.A. 1970

PRESQUE ISLE COUNTY RECORDED

93 DEC 20 PM 4:48

Janet M. Lamb REGISTER OF DEEDS

For corners in

| <u>PRESQUE ISLE</u> (County) | Located In: | Corner Code # |
|---------------------------------------|--------------------------|---------------|
| 1. Public Land Survey | T <u>34N</u> R <u>2E</u> | <u>C-4</u> |
| | T _____ R _____ | _____ |
| | T _____ R _____ | _____ |
| | T _____ R _____ | _____ |
| 2. Property Controlling in Section | S _____ T _____ R _____ | _____ |
| | S _____ T _____ R _____ | _____ |
| 3. Miscellaneous Property in Sec. | S _____ T _____ R _____ | _____ |
| | S _____ T _____ R _____ | _____ |

LIBER 307 PAGE 892

Register of Deeds Stamp & File Number

- 4. Lot No. _____, Recorded Plat _____
- 5. Private Claims _____

| | A | B | C | D | E | F | G | H | I | J | K | L |
|----|----|---|----|---|----|---|----|---|----|---|----|---|
| 2 | 6 | | 5 | | 4 | | 3 | | 2 | | | |
| 3 | | | | | | | | | | | | |
| 4 | 7 | ● | 8 | | 9 | | 10 | | 11 | | 12 | |
| 5 | | | | | | | | | | | | |
| 6 | 18 | | 17 | | 16 | | 15 | | 14 | | 13 | |
| 7 | | | | | | | | | | | | |
| 8 | 19 | | 20 | | 21 | | 22 | | 23 | | 24 | |
| 9 | | | | | | | | | | | | |
| 10 | 30 | | 29 | | 28 | | 27 | | 26 | | 25 | |
| 11 | | | | | | | | | | | | |
| 12 | 31 | | 32 | | 33 | | 34 | | 35 | | 36 | |

I, Ronald R. Bischer, in a field survey on September 3, 19 93, do hereby certify that under requirements of P.A. 74, Michigan P.A. of 1970, the corner points mentioned in lines 1 and 2 above were in conformance with regulations and rules therefore as required in the current manual of survey instructions of the United States Department of the Interior, Bureau of Land Management or by a decree of a Court of Law and/or that the corner points mentioned in lines 3, 4 and 5 above were in conformance with the rules of the Michigan Board of Land Surveyors or by a Decree of a Court of Law; established, re-established, monumented, re-monumented, recovered, found as expressed below:

NOTE: Not more than 4 corners, all in the same town and range, may be recorded on this certificate.

A. Description of original monument and accessories and/or subsequent restoration:


C-4
 July 1855
 Geo. H. Cannon set Wood Post
 15" Lynn S43°E 13 links
 9" Hemlock S45°W 11 links
 1973 - Delmar E. Porter
 Found Boat spike
 S73°W 82.37' 8" Apple tree
 N85°E 75.95' Telephone pole

Recorded on Page 38, Land Recordation, 12/20/73.
 1978 - Delmar E. Porter (Remonumentation)
 Found Boat spike, set monument box
 N87°E 75.65' Telephone pole
 S83°W 82.35' 9" Apple tree
 Recorded on Page 375, Land Recordation, 11/29/78.

B. Description of corner evidence found and/or method applied in restoring or reestablishing corner:

C-4
 Found Boat Spike in Monument Box
 N83°E 75.65' Telephone Pole

Replaced Boat Spike with 1/2" Rod and Cap #22428.

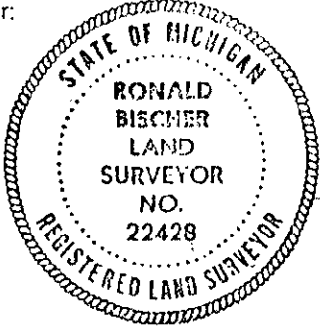

C. Description of monument for corner and accessories established to perpetuate locating the position of the corner:

C-4
 1/2" Rod and Cap #22428 in Monument Box
 N83°E 75.65' Telephone pole
 S83°W 115.56' 10" Apple tree
 N88°W 76.14' Telephone pole
 S40°E 76.44' 6" Scotch pine

Ratified by Peer Group
 in accordance with P.A. 345
 Chairman Delmar E. Porter
 Date December 7, 1993

*Witness tags and nails used.

Signed by Ronald R. Bischer
 Surveyor's Michigan License No. 22428

Date 12-13-93

C-4 Corner, Section 7, 8, Township 34N Range 2E

| <u>Activity</u> | <u>Monument & Accessories</u> | <u>Notes</u> |
|---|---|--------------|
| 1855 Resurvey Geo. H. Cannon | Set Wood Post 15" Lynn S43°E 13 links 9" Hemlock S45°W 11 links | : |
| 1973 Delmar E. Porter #15410 | Found Boat spike Set 2 witnesses Recorded on Page 38, Land Recordation, December 20, 1973 | |
| 1978 Delmar E. Porter #15410 | Found Boat spike Used 2 witnesses previously recorded. Recorded on Page 375, Land Recordation, November 29, 1978 | |
| 1993 Remonumentation Ronald R. Bischer #22428 | Found Boat spike in Monument Box Replaced boat spike w/½" Rod & cap #22428 N83°E 75.65' Telephone pole found nail w/tag #15410 S83°W 115.56' 10" Apple tree set nail w/tag #22428 N88°W 76.14' Telephone pole set nail w/tag #22428 S40°E 76.44' 6" Scotch pine set nail w/tag #22428 | |