

93 DEC 20 PM 4:49

LAND CORNER RECORDATION CERTIFICATE
Filing Requirement of Act 74, Mich. P.A. 1970

Janet M. Lamb
REGISTER OF DEEDS

For corners in
PRESQUE ISLE
(County)

Located In: Corner Code #/

1. Public Land Survey	T	<u>34N</u>	R	<u>2E</u>	<u>C-6</u>	
	T	_____	R	_____	_____	
	T	_____	R	_____	_____	
	T	_____	R	_____	_____	
2. Property Controlling in Section	S	_____	T	_____	R	_____
	S	_____	T	_____	R	_____
3. Miscellaneous Property in Sec.	S	_____	T	_____	R	_____
	S	_____	T	_____	R	_____

LIBER **307** PAGE **896**

Register of Deeds Stamp & File Number

- 4. Lot No. _____, Recorded Plat _____
- 5. Private Claims _____

A	B	C	D	E	F	G	H	I	J	K	L
2	6	5	4	3	2	1					
3											
4	7	8	9	10	11	12					
5											
6	18	17	16	15	14	13					
7											
8	19	20	21	22	23	24					
9											
10	30	29	28	27	26	25					
11											
12	31	32	33	34	35	36					
13											

I, Ronald R. Bischer, in a field survey on September 3, 19 93, do hereby certify that under requirements of P.A. 74, Michigan P.A. of 1970, the corner points mentioned in lines 1 and 2 above were in conformance with regulations and rules therefore as required in the current manual of survey instructions of the United States Department of the Interior, Bureau of Land Management or by a decree of a Court of Law and/or that the corner points mentioned in lines 3, 4 and 5 above were in conformance with the rules of the Michigan Board of Land Surveyors or by a Decree of a Court of Law; established, re-established, monumented, re-monumented, recovered, found as expressed below:

NOTE: Not more than 4 corners, all in the same town and range, may be recorded on this certificate.


A. Description of original monument and accessories and/or subsequent restoration:

C-6
 July 1855
 Geo. H. Cannon set Wood Post East 68.81' Power pole
 8" Beech S47°W 37 links N55°E 80.04' Telephone pole
 9" Beech S74°E 27 links West 110.86' Power pole
 1988 - Ronald R. Bischer Recorded on Page 715, Land
 Found 1-1/2" Pipe in Monument Box Recordation, June 8, 1988.
 (Set by MSHD)

B. Description of corner evidence found and/or method applied in restoring or reestablishing corner:

C-6
 Found 1-1/2" Pipe in Monument Box
 East 68.81' Power Pole
 West 110.86' Power Pole
 N67°E 80.04' Telephone Pole
 Raised 1-1/2" Pipe with 1/2" Rod and Cap #22428.

SURVEY &
 REMONUMENTATION
 1993
 COMMISSION

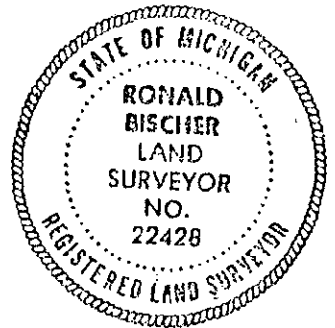

C. Description of monument for corner and accessories established to perpetuate locating the position of the corner:

C-6
 1/2" Rod and Cap #22428 inside 1-1/2" Pipe in Monument Box
 East 68.81' Power pole
 West 110.86' Power pole
 N67°E 80.04' Telephone pole
 N77°W 84.98' R/W Marker

Ratified by Peer Group
 in accordance with P.A. 345
 Chairman *Richard G. Porter*
 Date December 7, 1993

*Witness tags and nails used.

Signed by Ronald R. Bischer
 Surveyor's Michigan License No. 22428

Date 12-13-93

C-6 Corner, Section 17 & 18, Township 34N Range 2E

<u>Activity</u>	<u>Monument & Accessories</u>	<u>Notes</u>
1855 Resurvey Geo. H. Cannon	Set Wood Post 8" Beech S47°W 37 links 9" Beech S74°E 27 links	
1988 Ronald R. Bischer #22428	Found 1½" pipe in Monument box (MSHD) Set 3 witnesses Recorded on Page 715, Land Recordation, June 8, 1988	
1993 Remonumentation Ronald R. Bischer	Found 1½" pipe in monument box, raised w/½" rod and cap #22428 East 68.81' Power pole found nail w/tag #22428 West 110.86' Power pole found nail w/tag #22428 N67°E 80.04' Telephone pole found nail w/tag #22428 N77°W 84.98' R/W Marker	

3.