

1993

COMMISSIONER

LAND CORNER RECORDATION CERTIFICATE
Filing Requirement of Act 74, Mich. P.A. 1970

PRESQUE ISLE COUNTY
RECORDED

93 DEC 22 AM 10:01

Janet M. Lamb
REGISTER OF DEEDS

For corners in

<u>PRESQUE ISLE</u> (County)	Located In:	Corner Code #
1. Public Land Survey	T <u>34</u> R <u>2E</u>	<u>C-8</u>
	T _____ R _____	_____
	T _____ R _____	_____
	T _____ R _____	_____
2. Property Controlling in Section	S _____ T _____ R _____	_____
	S _____ T _____ R _____	_____
3. Miscellaneous Property in Sec.	S _____ T _____ R _____	_____
	S _____ T _____ R _____	_____

Register of Deeds Stamp & File Number

- 4. Lot No. _____, Recorded Plat _____
- 5. Private Claims _____

I, DELMER E. PORTER a field survey on SEPT. 11, 19 93, do hereby certify that under requirements of P.A. 74, Michigan P.A. of 1970, the corner points mentioned in lines 1 and 2 above were in conformance with regulations and rules therefore as required in the current manual of survey instructions of the United States Department of the Interior, Bureau of Land Management or by a decree of a Court of Law and/or that the corner points mentioned in lines 3, 4 and 5 above were in conformance with the rules of the Michigan Board of Land Surveyors or by a Decree of a Court of Law; established, re-established, monumented, re-monumented, recovered, found as expressed below:

NOTE: Not more than 4 corners, all in the same town and range, may be recorded on this certificate.

	A	B	C	D	E	F	G	H	I	J	K	L	M
2	6		5		4		3		2		1		
3													
4	7		8		9		10		11		12		
5													
6	18		17		16		15		14		13		
7													
8	19		20		21		22		23		24		
9													
10	30		29		28		27		26		25		
11													
12	31		32		33		34		35		36		
13													

A. Description of original monument and accessories and/or subsequent restoration:

C-8 GLO NOTES
 JULY 18, 1855
 HEMLOCK S 40° W 35 lks.
 HEMLOCK N 60° E 8 lks.

WITNESSES

N 64° E 93.88' 5" MAPLE
 S 76° E 97.48' 5" MAPLE
 S 56° E 113.39' 5" MAPLE

C-8

P.A. 74 FILING BY DELMER E. PORTER
 L.S. #15410 AUG. 25, 1978 PAGE 260
 LAND CORNER RECORDS


B. Description of corner evidence found and/or method applied in restoring or reestablishing corner:

C-8
 SEPT. 11, 1993
 FOUND 1/2" ROD & CAP #15410 in MONUMENT BOX
 N 65° E 94.00' 6" MAPLE
 S 74° E 97.55' 6" MAPLE
 S 54° E 113.63' 6" MAPLE

Ratified by Peer Group
 in accordance with P.A. 345
 Chairman Delmer E. Porter
 Date December 18, 1993

C. Description of monument for corner and accessories established to perpetuate locating the position of the corner:

C-8
 1/2" ROD & CAP IN MONUMENT BOX
 N 65° E 94.00' 6" MAPLE
 S 74° E 97.55' 6" MAPLE
 S 54° E 113.63' 6" MAPLE
 S 68° W 136.46' 5" SPRUCE
 * NAILS & TAGS #15410 USED ON WITNESSES
 PORTER'S SURVEY, P.C.

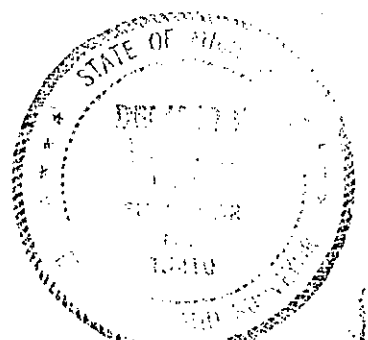

Signed by Delmer E. Porter

Date Dec 20, 1993

Surveyor's Michigan License No. 15410

CORNER HISTORY RESEARCH SHEET

C-8

T34N,R2E ALLIS TOWNSHIP-NORTH PART,
PRESQUE ISLE COUNTY, MICHIGAN.

ACTIVITY MONUMENT & ACCESSORIES - COMMENTS

GLO Survey
July 18, 1855

Hemlock 16" S40°W 35 Links
Hemlock 16" N60°E 8 Links

Act 74 filing by
Delmer E. Porter #15410
Aug. 25, 1978, Page 260,
Corner Recordation

Set 1/2" Rod & Cap in Mon. Box
by single proportion.
N64°E 93.88' 5" Maple Presque Isle
S76°E 97.48' 5" Maple County
S56°E 113.39' 5" Maple Remon.
Project

Act 132 survey by
Delmer E. Porter #15410
June 20, 1979
SUR#41-79 File#34R2105
Not Recorded

Same as above

Remonumentation
Sept. 11, 1993

FD. 1/2" Rod & Cap #15410 in Mon. Box
N65°E 94.00' 6" Maple
S74°E 97.55' 6" Maple
S54°E 113.63' 6" Maple
Left Same
N65°E 94.00' 6" Maple
S74°E 97.55' 6" Maple
S54°E 113.63' 6" Maple
S68°W 136.46' 5" Spruce

KS

SURVEY &
REMONUMENTATION

JAN 22 2001

SECTION