

1993

COMMISSIONER

LAND CORNER RECORDATION CERTIFICATE
Filing Requirement of Act 74, Mich. P.A. 1970

PRESQUE ISLE COUNTY
RECORDED

93 DEC 22 AM 10:01

Janet M. Lamb
REGISTER OF DEEDS

For corners in

<u>Presque Isle</u> (County)	Located In:	Corner Code #
1. Public Land Survey	T <u>34N</u> R <u>2E</u>	<u>C-9</u>
	T _____ R _____	_____
	T _____ R _____	_____
	T _____ R _____	_____
2. Property Controlling in Section	S _____ T _____ R _____	_____
	S _____ T _____ R _____	_____
3. Miscellaneous Property in Sec.	S _____ T _____ R _____	_____
	S _____ T _____ R _____	_____

Register of Deeds Stamp & File Number

- 4. Lot No. _____, Recorded Plat _____
- 5. Private Claims _____

I, Delmer E. Porter in a field survey on Sept. 7, 19 93, do hereby certify that under requirements of P.A. 74, Michigan P.A. of 1970, the corner points mentioned in lines 1 and 2 above were in conformance with regulations and rules therefore as required in the current manual of survey instructions of the United States Department of the Interior, Bureau of Land Management or by a decree of a Court of Law and/or that the corner points mentioned in lines 3, 4 and 5 above were in conformance with the rules of the Michigan Board of Land Surveyors or by a Decree of a Court of Law; established, re-established, monumented, re-monumented, recovered, found as expressed below:

NOTE: Not more than 4 corners, all in the same town and range, may be recorded on this certificate.

A	B	C	D	E	F	G	H	I	J	K	L	M
2	6	5	4	3	2	1						
3												
4	7	8	9	10	11	12						
5												
6	18	17	16	15	14	13						
7												
8	19	20	21	22	23	24						
9												
10	30	29	28	27	26	25						
11												
12	31	32	33	34	35	36						
13												

A. Description of original monument and accessories and/or subsequent restoration:

C-9 GLO Notes
July 18, 1855
Hemlock 12" N20° E 13 Links
Beech 10" S30° W 54 Links

Witnesses:
S70° W 108.90' P. Pole
N65° E 71.05' Stop Sign
S68° E 172.40' P. Pole

C-9 PA 74 filing by Ronald R. Bischer,
LS #22428, June 7, 1988, Page 715,
Land Corner Records
Found 1½" Pipe in Monument Box
By MSHD


B. Description of corner evidence found and/or method applied in restoring or reestablishing corner:

C-9 Sept. 7, 1993
Found 1½" Pipe in Monument Box
1' West of Centerline of M-33
S79° W 109.01' P. Pole ON4-9-15

Ratified by Peer Group
In accordance with P.A. 348
Chairman Delmer E. Porter
Date December 18, 1993

C. Description of monument for corner and accessories established to perpetuate locating the position of the corner:

C-9
1½" Pipe in Monument Box
S79° W 109.01' P. Pole ON4-9-15
S73° E 172.23' P. Pole ON4-9-1
N84° E 184.15' Metal Fence Post on Clear Vision Corner
N27° E 201.01' Metal Fence Post on Clear Vision Corner
Nails & tags #15410 used on witnesses
Porter's Survey P.C.

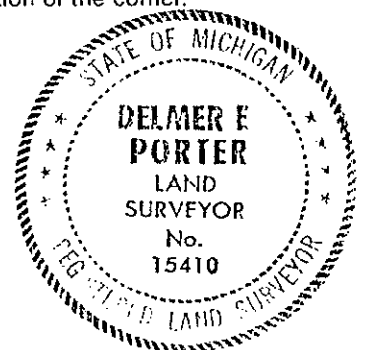

Signed by Delmer E. Porter Date Dec 20, 1993

Surveyor's Michigan License No. 15410

CORNER HISTORY RESEARCH SHEET

C-9

T34N,R2E ALLIS TOWNSHIP-NORTH PART,
PRESQUE ISLE COUNTY, MICHIGAN.

ACTIVITY	MONUMENT & ACCESSORIES	COMMENTS
----------	------------------------	----------

GLO Survey
July 18, 1855

Hemlock 12" N20°E 13 Links
Beech 10" S30°W 54 Links

Act 74 filing by
Ronald R. Bischer,
#22428, June 7, 1988,
Page 715, Corner
Recordation

Found 1½" Pipe in Mon. Box
By M.S.H.D.
Left Same
S70°W 108.90' P. Pole
N65°E 71.05' Stop Sign
S68°E 172.40' P. Pole

Remonumentation
Sept. 7, 1993

FD. 1½" Pipe in Mon. Box
1' West of Centerline crack of M-33 Hwy.
Left Same
S79°W 109.01' P. Pole #ON4-9-15
S73°E 172.23' P. Pole #ON-4-9-1
N84°E 184.15' Metal FE. Post on clear vision corner
N27°E 201.01' Metal FE. Post on clear vision corner

** 3'*

MONUMENT &
RECORDATION

JAN 22 2001

SECTION