

1993

PRESQUE ISLE COUNTY
RECORDED

93 DEC 22 AM 10:01

COMMISSION

LAND CORNER RECORDATION CERTIFICATE
Filing Requirement of Act 74, Mich. P.A. 1970

Gene M. Lamb
REGISTER OF DEEDS

For corners in

<u>PRESQUE ISLE</u> (County)	Located In:	Corner Code #
1. Public Land Survey	T <u>34N</u> R <u>2E</u>	<u>C-10</u>
	T _____ R _____	_____
	T _____ R _____	_____
	T _____ R _____	_____
2. Property Controlling in Section	S _____ T _____ R _____	_____
	S _____ T _____ R _____	_____
3. Miscellaneous Property in Sec.	S _____ T _____ R _____	_____
	S _____ T _____ R _____	_____

Register of Deeds Stamp & File Number

4. Lot No. _____, Recorded Plat _____
5. Private Claims _____

	A	B	C	D	E	F	G	H	I	J	K	L	M
2	6	5	4	3	2	1							
3													
4	7	8	9	10	11	12							
5													
6	18	17	16	15	14	13							
7													
8	19	20	21	22	23	24							
9													
10	30	29	28	27	26	25							
11													
12	31	32	33	34	35	36							
13													

I, DELMER E. PORTER field survey on SEPT. 7, 19 93, do hereby certify that under requirements of P.A. 74, Michigan P.A. of 1970, the corner points mentioned in lines 1 and 2 above were in conformance with regulations and rules therefore as required in the current manual of survey instructions of the United States Department of the Interior, Bureau of Land Management or by a decree of a Court of Law and/or that the corner points mentioned in lines 3, 4 and 5 above were in conformance with the rules of the Michigan Board of Land Surveyors or by a Decree of a Court of Law; established, re-established, monumented, re-monumented, recovered, found as expressed below:

NOTE: Not more than 4 corners, all in the same town and range, may be recorded on this certificate.

A. Description of original monument and accessories and/or subsequent restoration:

C-10
GLO NOTES
JULY 18, 1855
BEECH 12" N 73° E 41 lks.
BEECH 6" S 30° W 25 lks.

WITNESSES
FOUND 1 1/2" PIPE IN MONUMENT BOX
S 85° E 73.82' FENCE CORNER
S 88° W 70.92' GATE POST
N 78° W 72.08' GATE POST

C-10
Dec. 8, 1977
P.A. 74 FILING BY RONALD R. BISCHER
LS 22428 PAGE 209 LAND CORNER RECORDS


B. Description of corner evidence found and/or method applied in restoring or reestablishing corner:

C-10
FOUND 1 1/2" PIPE IN MONUMENT BOX
N 89° W 70.90' GATE POST
S 84° E 73.89' FENCE CORNER

Ratified by Peer Group
in accordance with P.A. 345
Chairman Delmer E. Porter
Date December 14, 1993

C. Description of monument for corner and accessories established to perpetuate locating the position of the corner:

C-10
1 1/2" PIPE IN MONUMENT BOX
N 89° W 70.90' GATE POST
N 60° W 88.91' SE CORNER BARN
S 84° E 73.89' FENCE CORNER
S 38° W 123.90' P. POLE (ON4-9-22
* NAILS AND TAGS #15410 USED IN WITNESSES
PORTER'S SURVEY, P.C.

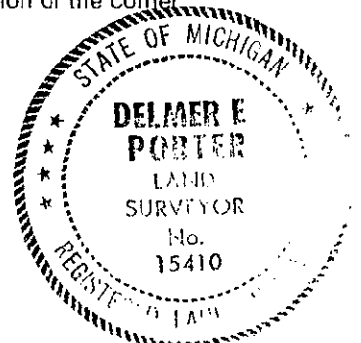

Signed by Delmer E. Porter

Date Dec 20, 1993

Surveyor's Michigan License No. 15410

CORNER HISTORY RESEARCH SHEET

C-10

T34N,R2E ALLIS TOWNSHIP-NORTH PART,
PRESQUE ISLE COUNTY, MICHIGAN.

ACTIVITY MONUMENT & ACCESSORIES - COMMENTS

GLO Survey
July 18, 1855

Beech 12" N73°E 41 Links
Beech 6" S30°W 25 Links

Act 74 filing by:
Ronald R. Bischer
#22428, Dec. 8, 1977,
Page 209, Corner
Recordation

Fd. 1 1/2" Pipe in Mon. Box
Left Same
S85°E 73.82' Fe. Cor.
S88°W 70.92' Gate Post
N78°W 72.08' Gate Post

Act 132 Survey by:
Porter's Survey
Not recorded
Nov. 23, 1977,
Survey#161-77
File#34R2091

Iron in Mon Box
0.94' West of CenterLine
S85°E 73.82' Fe. Cor.
N78°W 72.08 Gate Post
S88°W 70.92' Gate Post

Remonumentation
Sept. 7, 1993

Fd. 1 1/2" Pipe in Mon. Box
1' West of Centerline crack of
M-33 Hwy.
Left Same
N89°W 70.90' Gate Post (Fd.)
N60°W 88.91' SE Cor. Barn (New)
S84°E 73.89' Fe. Cor. (Fd.)
S38°W 123.90' P. Pole#ON4-9-22 (New)

SURVEY &
REMONUMENTATION

JAN 22 2001

SECTION