

1993

PRESQUE ISLE COUNTY
RECORDED

93 DEC 22 AM 10:01

COMMISSIONER

LAND CORNER RECORDATION CERTIFICATE
Filing Requirement of Act 74, Mich. P.A. 1970

For corners in

PRESQUE ISLE
(County)

Located In:

Corner Code #

- | | | | | | |
|---------------------------------------|---|------------|---|-----------|-------------|
| 1. Public Land Survey | T | <u>34N</u> | R | <u>2E</u> | <u>C-11</u> |
| | T | | R | | |
| | T | | R | | |
| | T | | R | | |
| 2. Property Controlling
in Section | S | | T | R | |
| | S | | T | R | |
| 3. Miscellaneous
Property in Sec. | S | | T | R | |
| | S | | T | R | |

Janet M. Lamb
REGISTER OF DEEDS

Register of Deeds Stamp & File Number

4. Lot No. _____, Recorded Plat _____
5. Private Claims _____

	A	B	C	D	E	F	G	H	I	J	K	L	M
2	6		5		4		3		2		1		
3													
4	7		8		9		10		11		12		
5													
6	18		17		16		15		14		13		
7													
8	19		20		21		22		23		24		
9													
10	30		29		28		27		26		25		
11													
12	31		32		33		34		35		36		
13													

I, DELMER E. PORTER, in a field survey on SEPT. 25, 19 93, do hereby certify that under requirements of P.A. 74, Michigan P.A. of 1970, the corner points mentioned in lines 1 and 2 above were in conformance with regulations and rules therefore as required in the current manual of survey instructions of the United States Department of the Interior, Bureau of Land Management or by a decree of a Court of Law and/or that the corner points mentioned in lines 3, 4 and 5 above were in conformance with the rules of the Michigan Board of Land Surveyors or by a Decree of a Court of Law; established, re-established, monumented, re-monumented, recovered, found as expressed below:

NOTE: Not more than 4 corners, all in the same town and range, may be recorded on this certificate.

A. Description of original monument and accessories and/or subsequent restoration:

C-11 GLO NOTES	FOUND 1½" PIPE IN MONUMENT BOX
JULY 18, 1855	N 88° E 76.95' FENCE CORNER
BEECH 10" S 85° E 32½ lks.	S 74° E 79.97' ANCHOR POLE
BEECH 12" N 14° W 32 lks.	S 70° W 83.60' P. POLE

C-11
P.A. 74 FILING BY RONALD R. BISCHER
L.S. #22428 OCT. 19, 1990 PAGE 815
LAND CORNER RECORDS


B. Description of corner evidence found and/or method applied in restoring or reestablishing corner:

C-11
SEPT. 25, 1993
FOUND 1½" PIPE IN MONUMENT BOX
S 76° W 83.65' P. POLE
S 68° E 80.41' ANCHOR POLE
S 39° E 77.00' FENCE CORNER
LEFT SAME

Ratified by Peer Group
in accordance with P.A. 345
Chairman Delmer E. Porter
Date December 18, 1993

C. Description of monument for corner and accessories established to perpetuate locating the position of the corner:

C-11
1½" PIPE IN MONUMENT BOX
S 76° W 83.65' P. POLE
S 42° E 161.08' 8" APPLE
S 68° E 80.41' ANCHOR POLE
S 52° W 198.78' R/W FENCE CORNER
* NAILS & TAGS #15410 USED IN WITNESSES
PORTER'S SURVEY, P.C.

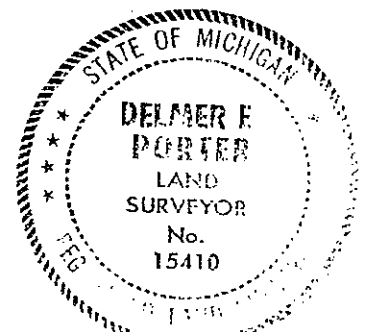

Signed by Delmer E. Porter Date Dec 20, 1993
Surveyor's Michigan License No. 15410

CORNER HISTORY RESEARCH SHEET

C-11

T34N,R2E ALLIS TOWNSHIP-NORTH PART,
PRESQUE ISLE COUNTY, MICHIGAN.

ACTIVITY	MONUMENT & ACCESSORIES	COMMENTS
----------	------------------------	----------

GLO Survey
July 187, 1855

Beech 10" S85°E 32½ Links
Beech 12" N14°W 32 Links

Act 74 filing by
Ronald R. Bischer,
#22428, Oct. 19, 1990,
Page 815, Corner
Recordation

Found 1½" Pipe in Mon. Box
Left Same
N88°E 76.95' FE. Cor.
S74°E 79.97' Anchor Pole
S70°W 83.60' P. Pole

Remonumentation
Sept. 25, 1993

FD. 1½" Pipe in Mon. Box
S76°W 83.65' P. Pole
S68°E 80.41' Anchor Pole
S39°E 77.00' FE. Cor.
Left Same
S76°W 83.65' P. Pole
S42°E 161.08' 8" Apple
S68°E 80.41' Anchor Pole
S52°W 198.78' R/W FE. Cor.