

RECORD

PRESQUE ISLE COUNTY  
RECORDED

1993

93 DEC 22 AM 10:01

COMMISSION

LAND CORNER RECORDATION CERTIFICATE  
Filing Requirement of Act 74, Mich. P.A. 1970

*Janet M. Lamb*  
REGISTER OF DEEDS

For corners in

<u>PRESQUE ISLE</u> (County)	Located In:	Corner Code #
1. Public Land Survey	T <u>34NR</u> <u>2E</u>	<u>C-13</u>
	T _____ R _____	_____
	T _____ R _____	_____
	T _____ R _____	_____
2. Property Controlling in Section	S _____ T _____ R _____	_____
	S _____ T _____ R _____	_____
3. Miscellaneous Property in Sec.	S _____ T _____ R _____	_____
	S _____ T _____ R _____	_____
4. Lot No. _____, Recorded Plat _____		
5. Private Claims _____		

Register of Deeds Stamp & File Number

A	B	C	D	E	F	G	H	I	J	K	L	M
2	6	5	4	3	2	1						
3												
4	7	8	9	10	11	12						
5												
6	18	17	16	15	14	13						
7												
8	19	20	21	22	23	24						
9												
10	30	29	28	27	26	25						
11												
12	31	32	33	34	35	36						
13												

I, DELMER E. PORTER a field survey on DEC. 9, 19 93, do hereby certify that under requirements of P.A. 74, Michigan P.A. of 1970, the corner points mentioned in lines 1 and 2 above were in conformance with regulations and rules therefore as required in the current manual of survey instructions of the United States Department of the Interior, Bureau of Land Management or by a decree of a Court of Law and/or that the corner points mentioned in lines 3, 4 and 5 above were in conformance with the rules of the Michigan Board of Land Surveyors or by a Decree of a Court of Law; established, re-established, monumented, re-monumented, recovered, found as expressed below:

NOTE: Not more than 4 corners, all in the same town and range, may be recorded on this certificate.

A. Description of original monument and accessories and/or subsequent restoration:

C-13 GLO NOTES  
JULY 14, 1855  
TAMARACK 8" N 42° W 36 lks.  
SPRUCE 12" N 70° E 29 lks.

C-13 P.A. 74 FILING BY DELMER E. PORTER  
AUG. 9, 1974 RECORDED PAGE 59  
LAND CORNER RECORDS  
FOUND SQUARE WOOD STAKE (MSHD)

WITNESSES

N 05° W 31.55' 14" SPRUCE  
S 30° W 26.62' 6" BALSAM  
N 70° E 21.13' 5" BALSAM  
C-13 P.A. 74 FILING BY  
DELMER E. PORTER REC. NOV. 6, 197  
PAGE 375 LAND CORNER RECORDS.  
SET CONCRETE MON. & BRASS CAP AT  
STAKE. N 30° W 31.85' 12" CEDAR  
S 60° W 52.50' 6" CEDAR  
S 32° E 49.04' 13" CEDA

B. Description of corner evidence found and/or method applied in restoring or reestablishing corner:


C-13  
DEC. 9, 1993  
FOUND CONCRETE MONUMENT AND BRASS CAP  
N 32° W 31.92' 12" CEDAR  
S 30° E 49.10' 14" CEDAR  
S 58° W 52.52' 8" CEDAR

Ratified by Peer Group  
in accordance with P.A. 345

Chairman Delmer E. Porter  
Date December 19, 1993

C. Description of monument for corner and accessories established to perpetuate locating the position of the corner:

C-13  
CONCRETE MONUMENT AND BRASS CAP  
N 32° W 31.92' 12" CEDAR  
S 30° E 49.10' 14" CEDAR  
S 58° W 52.52' 8" CEDAR  
N 45° W 1.41' 5" CEDAR POST  
\* NAILS AND TAGS #15410 USED IN WITNESSES  
PORTER'S SURVEY P.C.

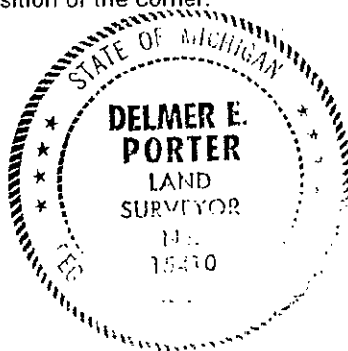

Signed by Delmer E. Porter

Date Dec 20, 1993

Surveyor's Michigan License No. 15410

# CORNER HISTORY RESEARCH SHEET

C-13

T34N,R2E ALLIS TOWNSHIP-NORTH PART,  
PRESQUE ISLE COUNTY, MICHIGAN.

## ACTIVITY                      MONUMENT & ACCESSORIES                      -                      COMMENTS

GLO Survey July 14, 1855	Tamarack 8" N42°W 36 Link Spruce 12" N70°E 29 Link	
Act 74 filing by: Delmer E. Porter #15410, Aug 9, 1974, Page 59, Corner Recordation	Fd. Square Wood Stake Left Same N05°W 31.55' 14" Spruce S30°W 26.62' 6" Balsam N70°E 21.13' 5" Balsam	Original Witness not Found
Act 132 Survey Recorded by: Porter's Survey Aug. 8, 1974 Lib.206, Pg.806	Corner not listed 2 Witnesses Recorded N05°W 31.55' 14" Spruce S70°W 21.13' 5" Balsam	
Act 74 filing by: Delmer E. Porter, #15410, Nov.6, 1978, Corner Recordation Page 375	Fd. Square Wood Hub(M.S.H.D.) N05°W 31.55' 14" Spruce S30°W 26.62' 6" Balsam N70°E 21.13' 5" Balsam and also Old Stake Point Set Conc. Mon. at Old Stake Point N30°W 31.85' 12" Cedar S60°W 52.50' 6" Cedar S32°E 49.04' 13" Cedar	Presque Isle County Remonu- mentation Project
Presque Isle Remonumentation Dec. 9, 1993	FD. 4" Conc. Mon. with brass cap and same witnesses N32°W 31.92' 12" Cedar S30°E 49.10' 14" Cedar S58°W 52.52' 8" Cedar N45°W 1.41' 5" Cedar Post	

Survey &  
REMONUMENTATION

JAN 22 2001

SECTION

2  
#