

93 DEC 20 PM 4:49

LAND CORNER RECORDATION CERTIFICATE
Filing Requirement of Act 74, Mich. P.A. 1970

Janet M. Lamb
REGISTER OF DEEDS

For corners in

<u>PRESQUE ISLE</u> (County)	Located In:	Corner Code <u>44</u>
1. Public Land Survey	T <u>34N</u> R <u>2E</u>	<u>D-1</u>
	T _____ R _____	_____
	T _____ R _____	_____
	T _____ R _____	_____
2. Property Controlling in Section	S _____ T _____ R _____	_____
	S _____ T _____ R _____	_____
3. Miscellaneous Property in Sec.	S _____ T _____ R _____	_____
	S _____ T _____ R _____	_____

LIBER 307 PAGE 898

Register of Deeds Stamp & File Number

4. Lot No. _____, Recorded Plat _____
5. Private Claims _____

A	B	C	D	E	F	G	H	I	J	K	L
2	6	5	4	3	2	1					
3											
4	7	8	9	10	11	12					
5											
6	12	17	16	15	14	13					
7											
8	19	20	21	22	23	24					
9											
10	30	29	28	27	26	25					
11											
12	31	32	33	34	35	36					
13											

I, Ronald R. Bischer, in a field survey on September 3, 19 93, do hereby certify that under requirements of P.A. 74, Michigan P.A. of 1970, the corner points mentioned in lines 1 and 2 above were in conformance with regulations and rules therefore as required in the current manual of survey instructions of the United States Department of the Interior, Bureau of Land Management or by a decree of a Court of Law and/or that the corner points mentioned in lines 3, 4 and 5 above were in conformance with the rules of the Michigan Board of Land Surveyors or by a Decree of a Court of Law; established, re-established, monumented, re-monumented, recovered, found as expressed below:

NOTE: Not more than 4 corners, all in the same town and range, may be recorded on this certificate.

A. Description of original monument and accessories and/or subsequent restoration:

D-1 Not set in Original Survey 1973 - Delmar E. Porter Set 1/2" Rod & Cap #15410 S40°E 35.41' 8" Maple S70°W 10.18' 7" Maple N88°E 41.00' 9" Maple Due W 28.62' 1" Pipe	Recorded on Page 27, Land Recordation, October 12, 1973. 1978 - Delmar E. Porter (Remonumentation) Found 1/2" Rod & Cap #15410, replaced with concrete monument w/brass cap. Used Porter witnesses from 1973. Recorded on Page 376, Land Recordation, November 29, 1978.
--	---


B. Description of corner evidence found and/or method applied in restoring or reestablishing corner:

Found Presque Isle County Remonumentation Monument
West 28.62' 1" Pipe
S40°E 35.41' 8" Maple
stump remains
S70°W 10.18' 7" Maple
stump remains
N88°E 41.00' 9" Maple
stump remains

SURVEY &
REMONUMENTATION

1993

COMMISSION

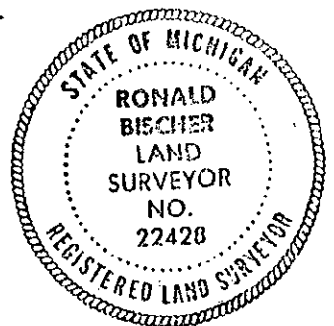

C. Description of monument for corner and accessories established to perpetuate locating the position of the corner:

D-1
Presque Isle County Remonumentation Monument
S38°E 35.75' 6" Maple
S39°W 36.44' 4" Lynn
East 38.01' 3" Cedar
N23°E 12.92' 3" White Pine

Ratified by Peer Group
in accordance with P.A. 345

Chairman Delmar E. Porter

Date December 7, 1993

Set nail with witness tag #22428 in witnesses.

Signed by Ronald R. Bischer

Date 12-13-93

Surveyor's Michigan License No. 22428

D-1 Corner, Section 5, Township 34N Range 2E

<u>Activity</u>	<u>Monument & Accessories</u>	<u>Notes</u>
Not recorded in Original Survey		
1973 Delmar E. Porter #15410	Set ½" Rod & cap #15410 Set three witnesses. Recorded on Page 27, Land Recordation, October 12, 1973	Set corner at inter- section of a line projected from the S¼ Corner over the Center ¼ to a line between the SE Corner and SW Corner of Section 32, T35N, R2E. Found 1" pipe Due W 28.62'.
1978 Remonumentation Delmar E. Porter #15410	Found ½" Rod & cap #15410 Set Concrete Monument w/Brass Cap Three witnesses. Recorded on Page 376, Land Recordation, November 29, 1978.	
1993 Remonumentation	Found Concrete Monument w/Brass Cap All witnesses are now stumps. 1" Pipe West 28.62' S38°E 35.75' 6" Maple set nail w/tag #22428 S39°W 36.44' 4" Lynn set nail w/tag #22428 East 38.01' 3" Cedar set nail w/tag #22428 N23°E 12.92' 3" White Pine set nail w/tag #22428	

#15.