

93 DEC 20 PM 4:49

LAND CORNER RECORDATION CERTIFICATE  
Filing Requirement of Act 74, Mich. P.A. 1970

*Janet M. Lamb*  
REGISTER OF DEEDS

For corners in

<u>PRESQUE ISLE</u> (County)	Located In:	Corner Code #/
1. Public Land Survey	T <u>34N</u> R <u>2E</u>	<u>D-5</u>
	T _____ R _____	_____
	T _____ R _____	_____
	T _____ R _____	_____
2. Property Controlling in Section	S _____ T _____ R _____	_____
	S _____ T _____ R _____	_____
3. Miscellaneous Property in Sec.	S _____ T _____ R _____	_____
	S _____ T _____ R _____	_____

LIBER **307** PAGE **902**

Register of Deeds Stamp & File Number

4. Lot No. \_\_\_\_\_, Recorded Plat \_\_\_\_\_  
5. Private Claims \_\_\_\_\_

	A	B	C	D	E	F	G	H	I	J	K	L	M
2	6		5		4		3		2		1		
3													
4	7		8		9		10		11		12		
5			●										
6	18		17		16		15		14		13		
7													
8	19		20		21		22		23		24		
9													
10	30		29		28		27		26		25		
11													
12	31		32		33		34		35		36		
13													

I, Ronald R. Bischer, in a field survey on September 3, 19 93, do hereby certify that under requirements of P.A. 74, Michigan P.A. of 1970, the corner points mentioned in lines 1 and 2 above were in conformance with regulations and rules therefore as required in the current manual of survey instructions of the United States Department of the Interior, Bureau of Land Management or by a decree of a Court of Law and/or that the corner points mentioned in lines 3, 4 and 5 above were in conformance with the rules of the Michigan Board of Land Surveyors or by a Decree of a Court of Law; established, re-established, monumented, re-monumented, recovered, found as expressed below:

**NOTE: Not more than 4 corners, all in the same town and range, may be recorded on this certificate.**

A. Description of original monument and accessories and/or subsequent restoration:

D-5  
July 1855  
Geo. H. Cannon set Wood Post N63°W 3.23' 2" Twin Cedar  
15" Sugar S20°W 24 links N67°E 20.43' 10" Twin Maple  
18" Sugar N20°W 18 links N37°E 30.14' 6" Maple  
1973 - Delmar E. Porter N59°W 53.65' 9" Maple  
Found Plow share and three N54°E 61.89' 8" Maple  
witnesses (MSHD), replaced plow share Due E 34.81' 6" Ash  
Recorded on Page 38, Land w/Concrete monument and Cap #15410 Recordation, December 20, 1973.


B. Description of corner evidence found and/or method applied in restoring or reestablishing corner:

D-5  
Found Concrete Monument with Cap #15410  
N63°W 2.35' Twin 6" Cedar  
N59°W 54.12' 11" Maple  
N45°E 61.95' 8" Cedar

SURVEY &  
REMONUMENTATION

1993

COMMISSION

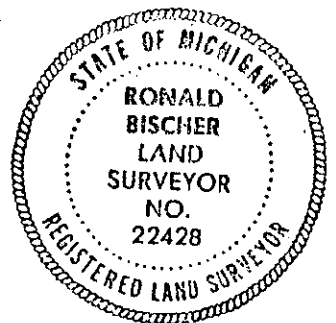

C. Description of monument for corner and accessories established to perpetuate locating the position of the corner:

D-5  
Concrete Monument with Cap #15410  
N63°W 2.35' Twin 6" Cedar  
N59°W 54.12' 11" Maple  
N45°E 61.95' 8" Cedar  
N85°E 20.04' 5" Lynn

Ratified by Peer Group  
in accordance with P.A. 345

Chairman *Delmar E. Porter*

Date December 7, 1993

Set nail with witness tag #22428 in witnesses.

Signed by Ronald R. Bischer

Date 12-13-93

Surveyor's Michigan License No. 22428

D-5 Corner, Section 8, 17, Township 34N Range 2E

<u>Activity</u>	<u>Monument &amp; Accessories</u>	<u>Notes</u>
1855 Resurvey Geo. H. Cannon	Set Wood Post 15" Sugar S20°W 24 links 18" Sugar N20°W 18 links	
1973 Delmar E. Porter #15410	Found plow share and three witnesses. (MSHD) Replaced plow share w/concrete monument and cap #15410, set three witnesses Recorded on Page 38, Land Recordation, December 20, 1973.	
1993 Remonumentation Ronald R. Bischer #22428	Found Concrete monument & cap #15410 N63°W 2.35' Tw. 6" Cedar found nail w/tag #15410 N59°W 54.12' 11" Maple found nail w/tag #15410 N45°E 61.95' 8" Cedar found nail w/tag #15410 N85°E 20.04' 5" Lynn set nail w/tag #22428	

#3,  
—