

1993

PRESQUE ISLE COUNTY
RECORDED

93 DEC 22 AM 10:01

COMMISSION

LAND CORNER RECORDATION CERTIFICATE
Filing Requirement of Act 74, Mich. P.A. 1970

Janet M. Lamb
REGISTER OF DEEDS

For corners in

<u>PRESQUE ISLE</u> (County)	Located In:	Corner Code #
1. Public Land Survey	T <u>34N</u> R <u>2E</u>	<u>D-7</u>
	T _____ R _____	_____
	T _____ R _____	_____
	T _____ R _____	_____
2. Property Controlling in Section	S _____ T _____ R _____	_____
	S _____ T _____ R _____	_____
3. Miscellaneous Property in Sec.	S _____ T _____ R _____	_____
	S _____ T _____ R _____	_____

Register of Deeds Stamp & File Number

4. Lot No. _____, Recorded Plat _____
5. Private Claims _____

	A	B	C	D	E	F	G	H	I	J	K	L	M
2	6	5	4	3	2								
3													
4	7	8	9	10	11	12							
5													
6	18	17	16	15	14	13							
7		●											
8	19	20	21	22	23	24							
9													
10	30	29	28	27	26	25							
11													
12	31	32	33	34	35	36							
13													

I, DELMER E. PORTER field survey on SEPT. 25, 19 93, do hereby certify that under requirements of P.A. 74, Michigan P.A. of 1970, the corner points mentioned in lines 1 and 2 above were in conformance with regulations and rules therefore as required in the current manual of survey instructions of the United States Department of the Interior, Bureau of Land Management or by a decree of a Court of Law and/or that the corner points mentioned in lines 3, 4 and 5 above were in conformance with the rules of the Michigan Board of Land Surveyors or by a Decree of a Court of Law; established, re-established, monumented, re-monumented, recovered, found as expressed below:

NOTE: Not more than 4 corners, all in the same town and range, may be recorded on this certificate.

A. Description of original monument and accessories and/or subsequent restoration:

D-7 GLO SURVEY JULY 17, 1855
BEECH 7" S 15° W 41 lks.
BEECH 8" N 43° E 15½ lks.
D-7 P.A. 74 FILING
BY DELMER E. PORTER
OCT. 20, 1975 page 91
LAND CORNER RECORDS
SET ½" ROD AND CAP #15410 33'
SOUTH OF CEMETERY FENCE

WITNESSES

N 09°E 34.74' F. POST
N09° W 33.11' P. POLE
S40°E 44.05' F. CORNER
S43°W 41.14' P. POLE
D-7 AUG. 26, 1978 P.A. 74
FILING BY DELMER E. PORTER
PG. 252 LAND CORNER RECORDS
FOUND SAME AS WITNESSES EXCEPT:

D-7 P.A. 74 FILING
BY DELMER E. PORTER
JAN. 12, 1981 pg41
LAND COR. RECORDS
FD. ½" ROD AND CAP
#15410 IN MON. BOX
N03°E 34.65' FE.CO
S53°W 43.77' P.PO
S28°E 41.51' F.CO


B. Description of corner evidence found and/or method applied in restoring or reestablishing corner: S 40° E 44.05' F.CO
SET MONUMENT BOX

D-7
SEPT. 25, 1993
FOUND ½" ROD AND CAP #15410
IN MONUMENT BOX
N 03° E 34.65' FENCE CORNER
S 53° W 43.77' POWER POLE
S 29° E 41.51' FENCE CORNER
LEFT SAME

Ratified by Peer Group
in accordance with P.A. 345
Chairman *Delmer E. Porter*
Date December 14, 1993

C. Description of monument for corner and accessories established to perpetuate locating the position of the corner:

D-7
½" ROD AND CAP #15410 IN MONUMENT BOX
NORTH 38.64' 30" MAPLE
S 16° E 60.08' 3" SPRUCE
N 80° E 131.26' 5" ASH
N 74° W 210.82' 20" MAPLE
* NAILS AND TAGS #15410 USED ON WITNESSES
PORTER'S SURVEY, P.C.

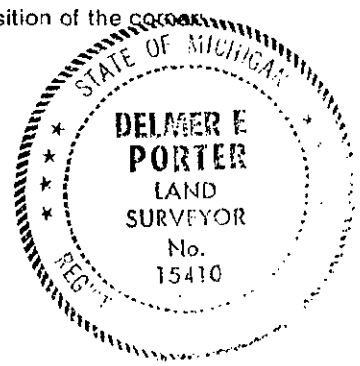

Signed by *Delmer E. Porter*

Date Dec 20, 1993

Surveyor's Michigan License No. 15410

CORNER HISTORY RESEARCH SHEET

D-7

T34N,R2E ALLIS TOWNSHIP-NORTH PART,
PRESQUE ISLE COUNTY, MICHIGAN.

ACTIVITY	MONUMENT & ACCESSORIES	COMMENTS
GLO Survey July 17, 1855	Beech 7" S15°W 41 Links Beech 8" N43°E 15 1/2 Links	
Act 74 filing by: Delmer E. Porter #15410, Oct. 20, 1975, Page 91, Corner Recordation	Set 1/2" Rod & Cap #15410 33' South of Cemetery Fence N09°E 34.74' Fe. Post N09°W 33.11' P. Pole S40°E 44.05' Fe. Cor. S43°W 41.14' P. Pole	
Act 74 filing by: Delmer E. Porter #15410, Aug. 26, 1978, Page 252, Corner Recordation	Fd. 1/2" Rod & Cap #15410 N09°E 34.74' Fe. Cor. S41°E 44.05' Fe. Cor. S43°W 41.14' P. Pole Set Monument Box	Presque Isle Co. Remon. Project
Act 74 filing by: Delmer E. Porter, #15410, Jan 12, 1981, Corner Recordation Page 459	Fd. 1/2" Rod & Cap #15410 (D. Porter) in center of road with State Mon. Box Left Same N03°E 34.65' Fe. Cor. S53°W 43.77' P. Pole S28°E 41.51' Fe. Cor.	Presque Isle Co. Remon. Project
Act 132 Survey filed by: Porter's Survey May 2, 1985 Survey#83-84 File#34R2162 Lib.279, Pg.721.	1/2" Rod & Cap in Mon Box N09°W 34.74' Fe. Cor. S41°E 44.05' Fe. Cor. S44°W 41.14' F. Pole	
Act 132 Survey filed by: Porter's Survey	1/2" Rod & Cap in Mon. Box N03°E 34.65' Fe. Cor. S28°E 41.51' Fe. Cor. S53°W 43.77' P. Pole	
Act 132 Survey by: Porter's Survey July 6, 1989, Sur#66-89, File#34R2221, Unrecorded	Fd. Same as above	
Remonumentation Sept. 25, 1993	Fd. 1/2" Rod & Cap #15410 in Mon. Box (Porter) N03°E 34.65' Fe. Cor. S53°W 43.77' P. Pole S28°E 41.51' Fe. Cor. Left Same Due North 38.64' 30" Maple S16°E 60.08' 3" Spruce N80°E 131.26' 5" Ash N74°W 210.82' 20" Maple	

#21