

93 DEC 22 AM 10:02

COMMISSION

LAND CORNER RECORDATION CERTIFICATE
Filing Requirement of Act 74, Mich. P.A. 1970

For corners in

Gene M. Lamb
REGISTER OF DEEDS

<u>PRESQUE ISLE</u> (County)	Located In:	Corner Code #
1. Public Land Survey	T <u>34N</u> R <u>2E</u>	<u>D-9</u>
	T _____ R _____	_____
	T _____ R _____	_____
2. Property Controlling in Section	S _____ T _____ R _____	_____
	S _____ T _____ R _____	_____
3. Miscellaneous Property in Sec.	S _____ T _____ R _____	_____
	S _____ T _____ R _____	_____

Register of Deeds Stamp & File Number

4. Lot No. _____, Recorded Plat _____
5. Private Claims _____

I, DELMER E. PORTER field survey on SEPT. 12, 19 93, do hereby certify that under requirements of P.A. 74, Michigan P.A. of 1970, the corner points mentioned in lines 1 and 2 above were in conformance with regulations and rules therefore as required in the current manual of survey instructions of the United States Department of the Interior, Bureau of Land Management or by a decree of a Court of Law and/or that the corner points mentioned in lines 3, 4 and 5 above were in conformance with the rules of the Michigan Board of Land Surveyors or by a Decree of a Court of Law; established, re-established, monumented, re-monumented, recovered, found as expressed below:

A	B	C	D	E	F	G	H	I	J	K	L	M
2	6	5	4	3	2	1						
3												
4	7	8	9	10	11	12						
5												
6	18	17	16	15	14	13						
7												
8	19	20	21	22	23	24						
9		●										
10	30	29	28	27	26	25						
11												
12	31	32	33	34	35	36						
13												

NOTE: Not more than 4 corners, all in the same town and range, may be recorded on this certificate.

A. Description of original monument and accessories and/or subsequent restoration:

D-9 GLO NOTES
BEECH 17" S 38° W 52 lks.
BEECH 6" N 04° E 38 lks.

WITNESSES
S 20° W 34.41' P. POLE
S 20° E 35.77' FENCE POST
N 45° W 55.90' FENCE CORNER

D-9
P.A. 74 FILING BY RONALD R. BISCHER
LS #22428 JUNE 7, 1988 PG. 715
LAND CORNER RECORDS
FOUND 1/2" ROD BY R.S. SCOTT AND ASSOC.


B. Description of corner evidence found and/or method applied in restoring or reestablishing corner:

D-9
SEPT. 12, 1993
FOUND 1/2" ROD
S 24° W 34.39' P. POLE
PLACED CAP ON ROD (#15410)

Ratified by Peer Group
in accordance with P.A. 345
Chairman *Delmer E. Porter*
Date *December 14, 1993*

C. Description of monument for corner and accessories established to perpetuate locating the position of the corner:

D-9
1/2" ROD AND CAP #15410
S 24° W 34.39' P. POLE # 0N4-98-7
N 10° E 221.43' 18" ELM
N 19° E 216.69' P. POLE # 0N4-98-7N
S 74° E 179.74' PHONE POLE
* NAILS AND TAGS #15410 USED ON WITNESSES
PORTER'S SURVEY, P.C.

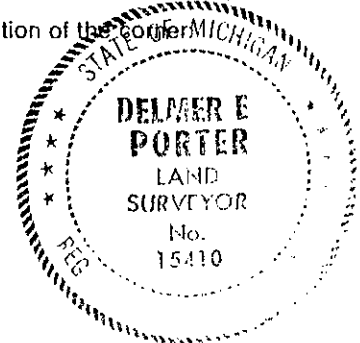

Signed by *Delmer E. Porter*
Surveyor's Michigan License No. 15410

Date Dec 20, 1993

CORNER HISTORY RESEARCH SHEET

D-9

T34N,R2E ALLIS TOWNSHIP-NORTH PART,
PRESQUE ISLE COUNTY, MICHIGAN.

ACTIVITY MONUMENT & ACCESSORIES - COMMENTS

GLO Survey
July 18, 1855

Beech 17" S38°W 52 Links
Beech 6" N04°E 38 Links

Act 132 Survey by:
Porter's Surey,
#15410, Sept.2, 1976,
Survey#129-76
File#34R2082
Unrecorded

Fd. 1/2" Rod by R. S. Scott
S20°W 34.41' P. Pole
S20°E 35.77' Fe. Post
N45°W 55.90' Cor. Fe. Post

Act 74 filing by:
Ronald R. Bischer,
#22428, June 7, 1988,
Page 715, Corner
Recordation

Fd. 1/2" Rod
Left Same
S20°W 34.41' P. Pole
S20°E 35.77' Fe. Post
N45°W 55.90' Fe. Cor.

Remonumentation
Sept.12, 1993

Fd. 1/2" Rod
S24°W 34.39' P. Pole
Left Same
S24°W 34.39' P. Pole #ON4-9B-7.
N10°E 221.43' 18" Elm
N19°E 216.69' P. Pole #ON4-9B-7N
S74°E 179.74' Phone Pole

REMONUMENTATION

JAN 22 2001

SECTION

#2