

1993

PRESQUE ISLE COUNTY
RECORDED

93 DEC 22 AM 10:02

COMMISSION

LAND CORNER RECORDATION CERTIFICATE
Filing Requirement of Act 74, Mich. P.A. 1970

Janet M. Lamb
REGISTER OF DEEDS

For corners in

Presque Isle (County)	Located In:	Corner Code #
1. Public Land Survey	T34N R2E	D-13
	T ___ R ___	_____
	T ___ R ___	_____
	T ___ R ___	_____
2. Property Controlling in Section	S ___ T ___ R ___	_____
	S ___ T ___ R ___	_____
3. Miscellaneous Property in Sec.	S ___ T ___ R ___	_____
	S ___ T ___ R ___	_____

Register of Deeds Stamp & File Number

- 4. Lot No. _____, Recorded Plat _____
- 5. Private Claims _____

	A	B	C	D	E	F	G	H	I	J	K	L	M
2	6		5		4		3		2		1		
3													
4	7		8		9		10		11		12		
5													
6	18		17		16		15		14		13		
7													
8	19		20		21		22		23		24		
9													
10	30		29		28		27		26		25		
11													
12	31		32		33		34		35		36		
13													

I, Delmer E. Porter in a field survey on December 8, 19 93, do hereby certify that under requirements of P.A. 74, Michigan P.A. of 1970, the corner points mentioned in lines 1 and 2 above were in conformance with regulations and rules therefore as required in the current manual of survey instructions of the United States Department of the Interior, Bureau of Land Management or by a decree of a Court of Law and/or that the corner points mentioned in lines 3, 4 and 5 above were in conformance with the rules of the Michigan Board of Land Surveyors or by a Decree of a Court of Law; established, re-established, monumented, re-monumented, recovered, found as expressed below:

NOTE: Not more than 4 corners, all in the same town and range, may be recorded on this certificate.

A. Description of original monument and accessories and/or subsequent restoration:

D-13 GLO Notes July 14, 1855 Cedar 14" N35°W 31 Links Cedar 6" N12°E 33 Links	D-13 PA 74 filing by Ronald R. Bischer LS #22428, Aug. 19, 1976, Page 151 Land Corner Records Found 1/2" Rod S10°W 17.88' 10" Spruce S72°W 49.48' 12" Spruce N05°E 41.79' Fence Corner
---	---


B. Description of corner evidence found and/or method applied in restoring or reestablishing corner:

D-13 Dec, 8, 1993
Found 1/2" Rod in Road Centerline
and raised with 1/2" Rod & Cap #15410
N05°E 41.79' Fence Corner
S72°W 49.48' 12" Spruce
S10°W 17.88' 10" Spruce

Ratified by Peer Group
in accordance with P.A. 345
Chairman Delmer E. Porter
Date December 18, 1993

C. Description of monument for corner and accessories established to perpetuate locating the position of the corner:

D-13
1/2" Rod & Cap #15410
S55°W 53.76' 8" Spruce
S26°E 27.18' 3" Cedar
N29°E 68.20' 8" Tamarack
N29°W 77.24' 11" Cedar
*Nails and tags #15410 used on witnesses
Porter's Survey P.C.

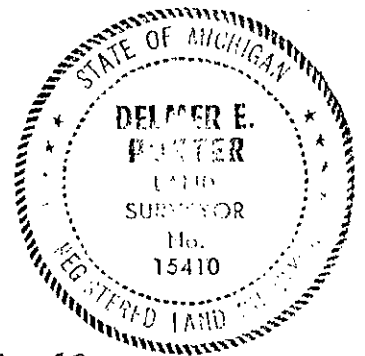

Signed by Delmer E. Porter
Surveyor's Michigan License No. 15410

Date Dec 20, 1993

CORNER HISTORY RESEARCH SHEET

D-13

_____, T34N,R2E ALLIS TOWNSHIP-NORTH PART,
PRESQUE ISLE COUNTY, MICHIGAN.

ACTIVITY MONUMENT & ACCESSORIES - COMMENTS

GLO Survey
July 14, 1855

Cedar 14" N35°W 31 Links
Cedar 6" N12°E 33 Links

Act 74 filing by
Ronald R. Bischer #22428
Aug. 19, 1976, Page 151
Corner Recordation

Found 1/2" Rod
Left Same
S10°W 17.88' 10" Spruce
S72°W 49.48' 12" Spruce
N05°E 41.79' FE Cor.

Presque Isle
Remonumentation
Dec. 8, 1993

Found 1/2" Rod in centerline
of 5 Mile Hwy.
and same witnesses as above
Witnesses in poor condition, replaced
Raised with 1/2" Rod & Cap #15410
S55°W 53.76' 8" Spruce
S26°E 27.18' 3" Cedar
N29°E 68.20' 8" Tamarack
N29°W 77.24' 11" Cedar

h.
h.