

93 DEC 20 PM 4: 50

LAND CORNER RECORDATION CERTIFICATE
Filing Requirement of Act 74, Mich. P.A. 1970

Janet M. Lamb
REGISTER OF DEEDS

For corners in

<u>PRESQUE ISLE</u> <small>(County)</small>	Located In:	Corner Code #
1. Public Land Survey	T <u>34N</u> R <u>2E</u>	<u>E-1</u>
	T _____ R _____	_____
	T _____ R _____	_____
	T _____ R _____	_____
2. Property Controlling in Section	S _____ T _____ R _____	_____
	S _____ T _____ R _____	_____
3. Miscellaneous Property in Sec.	S _____ T _____ R _____	_____
	S _____ T _____ R _____	_____
4. Lot No. _____, Recorded Plat _____		
5. Private Claims _____		

LIBER 307 PAGE 964

Register of Deeds Stamp & File Number

I, Ronald R. Bischer, in a field survey on September 7, 19 93, do hereby certify that under requirements of P.A. 74, Michigan P.A. of 1970, the corner points mentioned in lines 1 and 2 above were in conformance with regulations and rules therefore as required in the current manual of survey instructions of the United States Department of the Interior, Bureau of Land Management or by a decree of a Court of Law and/or that the corner points mentioned in lines 3, 4 and 5 above were in conformance with the rules of the Michigan Board of Land Surveyors or by a Decree of a Court of Law; established, re-established, monumented, re-monumented, recovered, found as expressed below:

A	B	C	D	E	F	G	H	I	J	K	L	M
2	6	5	4	3	2	1						
3												
4	7	8	9	10	11	12						
5												
6	18	17	16	15	14	13						
7												
8	19	20	21	22	23	24						
9												
10	30	29	28	27	26	25						
11												
12	31	32	33	34	35	36						
13												

NOTE: Not more than 4 corners, all in the same town and range, may be recorded on this certificate.

A. Description of original monument and accessories and/or subsequent restoration:

E-1
 1855 Resurvey - Geo. H. Cannon (July) S02°W 24.94' 20" Twin Elm
 Set Wood Post S45°E 34.77' Fence post
 8" Beech S45°E 44 links Recorded on Page 30, Land
 9" Beech S47°W 34 links Recordation, October 25, 1973.
 1978 - Delmar E. Porter (Remonumentation)
 Found 1-1/2" Pipe, replaced pipe with
 Concrete Monument w/Brass Cap.
 Used witnesses from 1973.
 Recorded on Page 376, Land Recordation, 11/29/78.


B. Description of corner evidence found and/or method applied in restoring or reestablishing corner:

E-1
Found Presque Isle County Remonumentation Monument
All old witnesses are gone.

SURVEY &
REMONUMENTATION

1993

COMMISSION

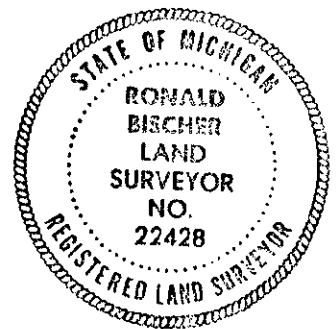

C. Description of monument for corner and accessories established to perpetuate locating the position of the corner:

E-1
Presque Isle Remonumentation Monument
N68°E 21.48' 5" Apple tree
N58°W 37.63' 4" Apple tree
South 27.28' 11" Maple
S64°E 36.09' 8" Apple tree

*Witness tags and nails used.

Ratified by Peer Group
in accordance with P.A. 345
Chairman *Delmar E. Porter*
Date December 7, 1993

Signed by Ronald R. Bischer

Date 12-13-93

Surveyor's Michigan License No. 22428