

PRESQUE ISLE COUNTY
RECORDED

93 DEC 20 PM 4:49

Janet M. Lamb
REGISTER OF DEEDS

LAND CORNER RECORDATION CERTIFICATE
Filing Requirement of Act 74, Mich. P.A. 1970

For corners in

PRESQUE ISLE
(County)

Located In:

Corner Code #/

- | | | |
|---------------------------------------|--------------------------|------------|
| 1. Public Land Survey | T <u>34N</u> R <u>2E</u> | <u>E-2</u> |
| | T _____ R _____ | _____ |
| | T _____ R _____ | _____ |
| | T _____ R _____ | _____ |
| 2. Property Controlling
in Section | S _____ T _____ R _____ | _____ |
| | S _____ T _____ R _____ | _____ |
| 3. Miscellaneous
Property in Sec. | S _____ T _____ R _____ | _____ |
| | S _____ T _____ R _____ | _____ |

LIBER **307** PAGE **904**

Register of Deeds Stamp & File Number

4. Lot No. _____, Recorded Plat _____
5. Private Claims _____

A	B	C	D	E	F	G	H	I	J	K	L
2	6	5	4	3	2	1					
3											
4	7	8	9	10	11	12					
5											
6	13	17	16	15	14	13					
7											
8	19	20	21	22	23	24					
9											
10	30	29	28	27	26	25					
11											
12	31	32	33	34	35	36					
13											

I, Ronald R. Bischer, in a field survey on September 7, 19 93, do hereby certify that under requirements of P.A. 74, Michigan P.A. of 1970, the corner points mentioned in lines 1 and 2 above were in conformance with regulations and rules therefore as required in the current manual of survey instructions of the United States Department of the Interior, Bureau of Land Management or by a decree of a Court of Law and/or that the corner points mentioned in lines 3, 4 and 5 above were in conformance with the rules of the Michigan Board of Land Surveyors or by a Decree of a Court of Law; established, re-established, monumented, re-monumented, recovered, found as expressed below:

NOTE: Not more than 4 corners, all in the same town and range, may be recorded on this certificate.

A. Description of original monument and accessories and/or subsequent restoration:

E-2

- | | |
|---------------------------------------|---|
| 1855 Resurvey - Geo. H. Cannon (July) | Due N 6.75' Corner fence post |
| Set Wood Post | N20°E 78.48' Power pole |
| 24" Yellow Birch N45°E 31 links | Recorded on Page 30, Land |
| 22" Cedar S31°W 19 links | Recordation, October 25, 1973. |
| 1973 - Delmar E. Porter | 1978 - Delmar E. Porter (Remonumentation) |
| Found 1/2" Rod & Cap #15410 | Found 1/2" Rod & Cap, replaced with Concrete |
| Due W 29.74' 4" Apple tree | Monument w/Brass Cap. Used 1973 Porter witnesses. |
| Due W 33.00' 1-1/4" Pipe | Recorded on Page 376, Land Recordation, 11/29/78. |

B. Description of corner evidence found and/or method applied in restoring or reestablishing corner:


E-2

- Presque Isle County Remonumentation Monument
- N32°E 78.48' Power pole
- N02°E 7.03' Fence corner
- N88°W 33.00' 1-1/4" Pipe and Cap #15410

SURVEY &
REMONUMENTATION

1993

COMMISSION

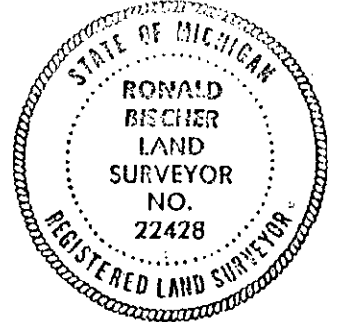

C. Description of monument for corner and accessories established to perpetuate locating the position of the corner:

E-2

- Presque Isle County Remonumentation Monument
- N32°E 78.48' Power pole
- N02°E 7.03' Fence corner
- N88°W 33.00' 1-1/4" Pipe and Cap #15410
- S02°W 6.53' 4" Black Cherry tree

Ratified by Peer Group
in accordance with P.A. 345

Chairman Delmar E. Porter

Date December 7, 1993

*Witness tags and nails used.

Signed by Ronald R. Bischer

Date 12-13-93

Surveyor's Michigan License No. 22428

E-2 Corner, Section 4, 5, Township 34N Range 2E

<u>Activity</u>	<u>Monument & Accessories</u>	<u>Notes</u>
1855 Resurvey Geo. H. Cannon	Set Wood Post 24" Yellow Birch N45°E 31 links 22" Cedar S31°W 19 links	
1973 Delmar E. Porter #15410	½" Rod & Cap #15410 4 witnesses Recorded on Page 30, Land Recordation, October 25, 1973	
1978 Remonumentation Delmar E. Porter #15410.	Found ½" Rod & cap #15410, replaced w/Concrete monument w/Brass cap 3 witnesses Recorded on Page 376, Land Recordation, November 29, 1978	
1993 Remonumentation Ronald R. Bischer #22428	Found Concrete monument w/Brass cap N32°E 78.48' Power pole found nail w/tag #15410 N02°E 7.03' Fence corner found nail w/tag #15410 N88°W 33.00' 1½" pipe & cap #15410 S02°W 6.53' 4" Black Cherry Tree set nail w/tag #22428	

~~#3~~