

1993

PRESQUE ISLE COUNTY
RECORDED

93 DEC 22 AM 10:02

COMMISSION

LAND CORNER RECORDATION CERTIFICATE
Filing Requirement of Act 74, Mich. P.A. 1970

Janet M. Lamb
REGISTER OF DEEDS

For corners in

<u>PRESQUE ISLE</u> (County)	Located In:	Corner Code #
1. Public Land Survey	T 34NR 2E	E-8
	T _____ R _____	_____
	T _____ R _____	_____
	T _____ R _____	_____
2. Property Controlling in Section	S _____ T _____ R _____	_____
	S _____ T _____ R _____	_____
3. Miscellaneous Property in Sec.	S _____ T _____ R _____	_____
	S _____ T _____ R _____	_____

Register of Deeds Stamp & File Number

4. Lot No. _____, Recorded Plat _____
5. Private Claims _____

A	B	C	D	E	F	G	H	I	J	K	L	M
2	6	5	4	3	2	1						
3												
4	7	8	9	10	11	12						
5												
6	18	17	16	15	14	13						
7												
8	19	20	21	22	23	24						
9												
10	30	29	28	27	26	25						
11												
12	31	32	33	34	35	36						
13												

I, DELMER E. PORTER a field survey on DEC. 9, 1993, do hereby certify that under requirements of P.A. 74, Michigan P.A. of 1970, the corner points mentioned in lines 1 and 2 above were in conformance with regulations and rules therefore as required in the current manual of survey instructions of the United States Department of the Interior, Bureau of Land Management or by a decree of a Court of Law and/or that the corner points mentioned in lines 3, 4 and 5 above were in conformance with the rules of the Michigan Board of Land Surveyors or by a Decree of a Court of Law; established, re-established, monumented, re-monumented, recovered, found as expressed below:

NOTE: Not more than 4 corners, all in the same town and range, may be recorded on this certificate.

A. Description of original monument and accessories and/or subsequent restoration:

E-8 GLO NOTES
JULY 16, 1855
SUGAR 8" S 34° W 34 lks.
BEECH 24" N 25° E 38½ lks.

E-8 P.A. 74 FILING BY RONALD R. BISCHER
L.S. 22428 MAY 30, 1984 pg. 648
LAND CORNER RECORDS
SET ½" ROD AND CAP #15410 BY SINGLE PROPORTION

WITNESSES
N 05° W 9.06' 12" LYNN
S 85° E 2.22' 7" LYNN
S 80° W 8.98' 4" MAPLE
N 55° W 53.97' 20" ASH
FENCE CORNER 29' WEST
FENCE CORNER TO EAST 51' SOUTH


B. Description of corner evidence found and/or method applied in restoring or reestablishing corner:

E-8
DEC. 9, 1993
FOUND ½" ROD & CAP #15410
N 04° W 8.98' 13" LYNN
S 85° W 9.05' 4" MAPLE

Ratified by Peer Group
in accordance with P.A. 345
Chairman *Delmer E. Porter*
Date December 17, 1993

C. Description of monument for corner and accessories established to perpetuate locating the position of the corner:

E-8
½" ROD & CAP #15410
S 85° W 9.05' 4" MAPLE
N 43° W 28.65' 9" MAPLE
N 04° W 8.98' 13" LYNN
S 45° E 18.63' 6" MAPLE
* NAILS AND TAGS #15410 USED IN WITNESSES
PORTER'S SURVEY, P.C.

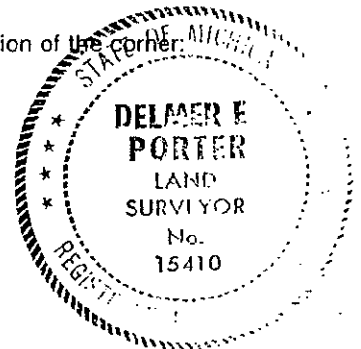

Signed by *Delmer E. Porter*

Date Dec 20, 1993

Surveyor's Michigan License No. 15410

CORNER HISTORY RESEARCH SHEET

E-8

T34N,R2E ALLIS TOWNSHIP-NORTH PART,
PRESQUE ISLE COUNTY, MICHIGAN.

ACTIVITY MONUMENT & ACCESSORIES - COMMENTS

GLO Survey
July 16, 1855

Sugar 8" S34°W 34 Links
Beech 24" N25°E 38 1/2 Links

Act 74 filing by:
Ronald R. Bischer
#22428, May 30, 1984,
Page 648, Corner
Recordation

Set 1/2" Rod & Cap #15410
by Single Proportion
N05°W 9.06' 12" Lynn
S85°E 2.22' 7" Lynn
S80°W 8.98' 4" Maple
N55°W 53.97' 20" Ash
Fence Corner 29' West
Fence to East 51' South

Act 132 Survey by:
Delmer E. Porter,
#15410, May 11, 1984,
Survey#40-84,
File#34R2154
Lib.258, Pg.464

1/2" Rod & Cap (Porter)#15410
Same Witness

Act 132 Survey by:
Delmer E. Porter
#15410,
Survey#73-84
File#34R2159
Lib.265 Pg.546

Fd. 1/2" Rod & Cap #15410(Porter)
Same Witnesses

Presque Isle
Remonumentation
Dec. 9, 1993

Found 1/2" rod & Cap #15410
Found same witnesses
Replaced two which were in
poor condition
S85°W 9.05' 4" Maple
N43°W 28.65' 9" Maple
N04°W 8.98' 13" Lynn
S45°E 18.63' 6" Maple

#5