

1993

PRESQUE ISLE COUNTY
RECORDED

93 DEC 22 AM 10:02

COMM.

LAND CORNER RECORDATION CERTIFICATE
Filing Requirement of Act 74, Mich. P.A. 1970

Janet M. Lamb
REGISTER OF DEEDS

For corners in
PRESQUE ISLE
(County)

Located In: Corner Code #

- | | | | | |
|------------------------------------|---|-------------|-----------|-------------|
| 1. Public Land Survey | T | <u>34</u> N | <u>2E</u> | <u>E-10</u> |
| | T | ___ | R ___ | _____ |
| | T | ___ | R ___ | _____ |
| | T | ___ | R ___ | _____ |
| 2. Property Controlling in Section | S | ___ | T ___ | _____ |
| | S | ___ | T ___ | _____ |
| 3. Miscellaneous Property in Sec. | S | ___ | T ___ | _____ |
| | S | ___ | T ___ | _____ |

Register of Deeds Stamp & File Number

4. Lot No. _____, Recorded Plat _____
5. Private Claims _____

I, DELMER E. PORTER a field survey on DEC. 9, 19 93, do hereby certify that under requirements of P.A. 74, Michigan P.A. of 1970, the corner points mentioned in lines 1 and 2 above were in conformance with regulations and rules therefore as required in the current manual of survey instructions of the United States Department of the Interior, Bureau of Land Management or by a decree of a Court of Law and/or that the corner points mentioned in lines 3, 4 and 5 above were in conformance with the rules of the Michigan Board of Land Surveyors or by a Decree of a Court of Law; established, re-established, monumented, re-monumented, recovered, found as expressed below:

NOTE: Not more than 4 corners, all in the same town and range, may be recorded on this certificate.

A. Description of original monument and accessories and/or subsequent restoration:

E-10 GLO NOTES
JULY 16, 1855
BEECH 10" S 78° E 43 lks.
SUGAR 22" S 37° W 55 lks.

E-10
P.A. 74 FILING BY DELMER E. PORTER
L.S. #15410 SEPT 9, 1976 PG. 152
LAND CORNER RECORDS
SET 1/2" ROD & CAP #15410 BY SINGLE PROPORTION


WITNESSES
N 22° E 45.73' 8" MAPLE
S 44° E 19.05' 12" R. WOOD
(BASSWOOD
N 65° W 49.10' 5" IRONWOOD
SOUTH 59' TO FE. HEADING W
E-10 P.A 74 FILED BY
DELMER E. PORTER
L.S. #15410 NOV. 6, 1976
WITNESSED SAME REPLACED WI
CONC. MON. & BRASS
PRESQUE ISLE COUNTY
REMONUMENTATION

B. Description of corner evidence found and/or method applied in restoring or reestablishing corner:
E-10
DEC. 9, 1993
FOUND 4" CONCRETE MONUMENT WITH BRASS CAP
N 22° E 46.09' 9" MAPLE
S 44° E 19.05' 12" BASSWOOD (POOR CONDITION)
N 65° W 48.91' 7" IRONWOOD

Ratified by Peer Group
in accordance with P.A. 345
Chairman *Delmer E. Porter*
Date December 14, 1993

C. Description of monument for corner and accessories established to perpetuate locating the position of the corner

E-10
4" CONCRETE MONUMENT WITH BRASS CAP
S 17° E 20.06' 8" MAPLE
N 64° W 48.91' 7" IRONWOOD
N 22° E 46.09' 9" MAPLE
S 57° W 36.48' 10" MAPLE
* NAILS AND TAGS #15410 USED IN WITNESSES
PORTER'S SURVEY, P.C.

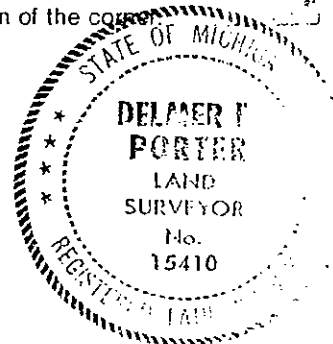

Signed by *Delmer E. Porter*
Surveyor's Michigan License No. 15410

Date Dec 20, 1993

CORNER HISTORY RESEARCH SHEET

E-10

T34N,R2E ALLIS TOWNSHIP-NORTH PART,
PRESQUE ISLE COUNTY, MICHIGAN.

ACTIVITY MONUMENT & ACCESSORIES - COMMENTS

GLO Survey
July 16, 1855

Beech 10" S78°E 43 Links
Sugar 22" S37°W 55 Links

Act 132 Survey by:
Delmer E. Porter
#15410, Sept. 2 1976
Survey#129-76
File#34R2062
Lib. Pg:

Witness & Corner
Same as below

Act 74 filing by:
Delmer E. Porter
#15410, Sept 9, 1976,
Page 152, Corner
Recordation

Set 1/2" Rod ¹/₇ Cap #15410
by Single Proportion
N22°E 45.73' 8" Maple
S44°E 19.05' 12" R. Wood
N65°W 49.10' 5" Ironwood
South 59' to Fence West

Act 74 Survey by:
Delmer E. Porter
#15410, Nov. 6, 1976,
Page 376, Corner
Recordation

Fd. 1/2" Rod & Cap #15410
N22°E 43.73' 8" Maple Presque Isle
S44°E 19.05' 18" Basswood County
N65°W 49.10' 5" Ironwood Remon. Project
Replaced w/P.I. County Remon.
Conc. Mon, w/Brass Cap
Same Witness

Act 132 Survey by:
Delmer E. Porter
#15410, Sept. 25, 1980,
Survey#89-80,
File#34R2117
Lib. 239, Pg. 394

Fd. 4" Conc. Mon.
with Brass Cap
Same Witnesses
as above

Act 132 Survey by:
Delmer E. Porter
#15410, Apr. 13, 1990,
Survey#168-89,
File#34R2233

Fd. 4" Conc. Mon.
with Brass Cap
Same Witnesses
as above

Presque Isle County
Remonumentation
Dec. 9, 1993

N
FD. 4" Conc. Mon. with
brass cap & same witnesses
Basswood was in poor condition, replaced
S17°E 20.06' 8" Maple
S64°W 48.91' 7" Ironwood
N22°E 46.09' 9" Maple
S57°W 36.48' 10" Maple

75