

1993

COMMISSION

LAND CORNER RECORDATION CERTIFICATE
Filing Requirement of Act 74, Mich. P.A. 1970

Janet M. Lamb
REGISTER OF DEEDS

For corners in

<u>Presque Isle</u> <small>(County)</small>	Located In:	Corner Code #
1. Public Land Survey	T <u>34N</u> R <u>2E</u>	<u>E-11</u>
	T _____ R _____	_____
	T _____ R _____	_____
	T _____ R _____	_____
2. Property Controlling in Section	S _____ T _____ R _____	_____
	S _____ T _____ R _____	_____
3. Miscellaneous Property in Sec.	S _____ T _____ R _____	_____
	S _____ T _____ R _____	_____

Register of Deeds Stamp & File Number

4. Lot No. _____, Recorded Plat _____
5. Private Claims _____

A	B	C	D	E	F	G	H	I	J	K	L
2	6	5	4	3	2	1					
3											
4	7	8	9	10	11	12					
5											
6	18	17	16	15	14	13					
7											
8	19	20	21	22	23	24					
9											
10	30	29	28	27	26	25					
11											
12	31	32	33	34	35	36					
13											

Delmer E. Porter in a field survey on Dec, 9, 19 93, do hereby certify that under requirements of P.A. 74, Michigan P.A. of 1970, the corner points mentioned in lines 1 and 2 above were in conformance with regulations and rules therefore as required in the current manual of survey instructions of the United States Department of the Interior, Bureau of Land Management or by a decree of a Court of Law and/or that the corner points mentioned in lines 3, 4 and 5 above were in conformance with the rules of the Michigan Board of Land Surveyors or by a Decree of a Court of Law; established, re-established, monumented, re-monumented, recovered, found as expressed below:

NOTE: Not more than 4 corners, all in the same town and range, may be recorded on this certificate.

A. Description of original monument and accessories and/or subsequent restoration:

E-11 GLO Notes	Witnesses
Cedar 8" S10°W 29 Links	Replaced with 1/2" Rod & Cap #15410
Hemlock 10" N30°E 18 Links	N60°E 18.26' 6" Spruce
E-11 PA 74 filing by Delmer E. Porter	S56°W 29.30' 6" Cedar
LS#15410, Sept. 8, 1976, Page 152,	S12°E 20.25' 8" Twin Cedar
Land Corner Records	E-11 PA 74 filing by Delmer E. Porter
Found Iron bar & Stake	LS #15410, Nov. 6, 1978, replaced 1/2"
N30°E 11.9' O.B.T. Stump	Rod with 4" Conc. Monument & Brass Cap
S10°W 18.1' O.B.T. Cedar (Dead)	P.I. Co. Remon. - Witness are same as previous
Standing with good face marking	


B. Description of corner evidence found and/or method applied in restoring or reestablishing corner:

E-11
FOUND 4" CONCRETE MONUMENT
AND BRASS CAP
S 10° E 20.37' 9" TWIN CEDAR
S 57° W 29.18' 7" CEDAR

Ratified by Peer Group
in accordance with P.A. 345
Chairman Delmer E. Porter
Date December 14, 1993

C. Description of monument for corner and accessories established to perpetuate locating the position of the corner:

E-11
4" CONCRETE MONUMENT WITH BRASS CAP
S 10° E 20.37' 9" TWIN CEDAR
S 57° W 29.18' 7" CEDAR
N 33° W 41.45' 3" CEDAR
N 18° E 11.78' 6" BALSAM
* NAILS AND TAGS #15410 USED IN WITNESSES
PORTER'S SURVEY, P.C.

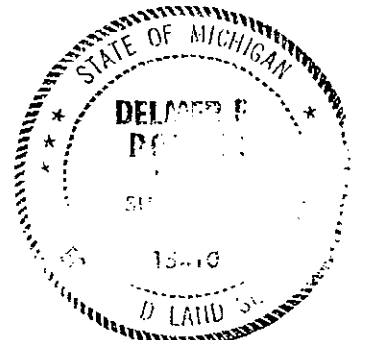

Signed by Delmer E. Porter
Surveyor's Michigan License No. 15410

Date Dec 20, 1993

CORNER HISTORY RESEARCH SHEET

E-11

T34N,R2E ALLIS TOWNSHIP-NORTH PART,
PRESQUE ISLE COUNTY, MICHIGAN.

ACTIVITY MONUMENT & ACCESSORIES - COMMENTS

GLO Survey July 14, 1855	Cedar 8" S10°W 29 Links Hemlock 10" N30°E 18 Links	
Act 74 filing by: Delmer E. Porter #15410, Sept. 8, 1976 Page 152, Corner Recordation	Fd. Iron Bar & Stake N30°E 11.9' O.B.T. Stump S10°W 18.1' O.B.T. Cedar (Dead) -Standing/good face marking Replaced with 1/2" Rod & Cap#15410 N60°E 18.26' 6" Spruce S56°W 29.30' 6" Cedar S12°E 20.25' 8" Twin Cedar	
Act 132 Survey by: Delmer e. Porter #15410, Sept. 2, 1976, SURVEY#129-76 File#34R2082 Lib. Pg.	Fd. 4" Conc. Mon. with Brass Cap Same Witness as above/below	
Act 74 filing by: Delmer E. Porter #15410, Nov. 6, 1978 Corner Recordation	Fd. 1/2" Rod & Cap#15410 N60°E 18.26' 6" Spruce S56°W 29.30' 6" Cedar S12°E 20.25' 8" Tw. Cedar Project Replaced w/P.I. County Remon. Conc. Mon. & Brass Cap Same Witnesses	Pesque Isle County Remonumentation
Presque Isle Remonumentation Dec. 9, 1993	FD. 4" Conc. Mon. with brass cap and same witnesses, Replaced spruce which was in poor condition S10°E 20.37' 9" Twin Cedar S57°W 29.18 7" Cedar N33°W 41.45' 3" Cedar N18°E 11.78' 6" Balsam	

1/2
#