

1993

PRESQUE ISLE COUNTY
RECORDED

93 DEC 22 AM 10:00

COMMISSION

LAND CORNER RECORDATION CERTIFICATE
Filing Requirement of Act 74, Mich. P.A. 1970

Jane M. Lamb
REGISTER OF DEEDS

For corners in

PRESQUE ISLE	Located In:	Corner Code #
1. Public Land Survey	T <u>34NR 2E</u>	<u>E-12</u>
	T _____ R _____	_____
	T _____ R _____	_____
	T _____ R _____	_____
2. Property Controlling in Section	S _____ T _____ R _____	_____
	S _____ T _____ R _____	_____
3. Miscellaneous Property in Sec.	S _____ T _____ R _____	_____
	S _____ T _____ R _____	_____

Register of Deeds Stamp & File Number

4. Lot No. _____, Recorded Plat _____
5. Private Claims _____

	A	B	C	D	E	F	G	H	I	J	K	L	M
2	6	5	4	3	2	1							
3													
4	7	8	9	10	11	12							
5													
6	18	17	16	15	14	13							
7													
8	19	20	21	22	23	24							
9													
10	30	29	28	27	26	25							
11													
12	31	32	33	34	35	36							
13													

I, DELMER E. PORTER a field survey on SEPT. 13, 19 93, do hereby certify that under requirements of P.A. 74, Michigan P.A. of 1970, the corner points mentioned in lines 1 and 2 above were in conformance with regulations and rules therefore as required in the current manual of survey instructions of the United States Department of the Interior, Bureau of Land Management or by a decree of a Court of Law and/or that the corner points mentioned in lines 3, 4 and 5 above were in conformance with the rules of the Michigan Board of Land Surveyors or by a Decree of a Court of Law; established, re-established, monumented, re-monumented, recovered, found as expressed below:

NOTE: Not more than 4 corners, all in the same town and range, may be recorded on this certificate.

A. Description of original monument and accessories and/or subsequent restoration:

E-12
GLO NOTES, JULY 14, 1855
SUGAR 12" S 55° E 12½ lks.
E-12
P.A. 74 FILING BY DELMER E. PORTER
L.S. #15410 AUG. 19, 1975 PAGE 86
LAND CORNER RECORDS. FOUND AXLE SHAFT
SOUTH 33.94' FENCE POST
N 55° E 105.39' 8" MAPLE
N 30° E 89.73' 10" MAPLE

E-12
P.A. 74 FILING BY DELMER E. PORTER
L.S. #15410 SEPT. 14, 1978 PG. 295
LAND CORNER RECORDS
FOUND AXLE SHAFT AND PLACED
MONUMENT BOX ON CORNER
LEFT SAME WITNESSES


B. Description of corner evidence found and/or method applied in restoring or reestablishing corner:

E-12
SEPT 13, 1993
FOUND ½" ROD AND CAP #15410 IN MONUMENT BOX
N 56° E 105.74' 22" MAPLE

Ratified by Peer Group
in accordance with P.A. 345
Chairman *Delmer E. Porter*
Date *December 18, 1995*

C. Description of monument for corner and accessories established to perpetuate locating the position of the corner

E-12
½" ROD & CAP #15410 IN MONUMENT BOX
N 32° E 69.73' 10" ELM
N 56° E 105.74' 22" MAPLE
N 77° E 112.36' 18" ELM
S 71° E 183.93' 12" SPRUCE
* NAILS AND TAGS #15410 USED ON WITNESSES
PORTER'S SURVEY, P.C.

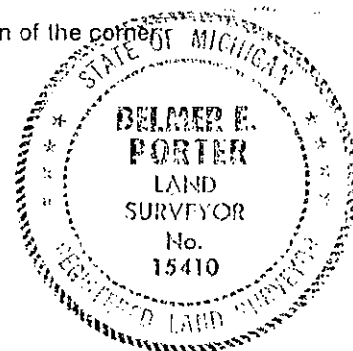

Signed by *Delmer E. Porter* Date *Dec 20, 1993*
Surveyor's Michigan License No. 15410

CORNER HISTORY RESEARCH SHEET

E-12

T34N,R2E ALLIS TOWNSHIP-NORTH PART,
PRESQUE ISLE COUNTY, MICHIGAN.

ACTIVITY MONUMENT & ACCESSORIES - COMMENTS

GLO Survey July 14, 1855	Sugar 12" S55°E 12 1/2 Links Hemlock 10" N45°W 29 Links	
Act 132 Survey by: Delmer E. Porter, #15410, Aug.18, 1975 Survey#75-75 File#34R2069 Lib. Pg.	Fd. Axle Shaft Same Witnesses	
Act 74 filing by: Delmer E. Porter, #15410, Aug.19, 1975, Page 86, Corner Recordation	Fd. Axle Shaft Sec. Subdivision 1968 Left Same South 33.94' Fe. Post N55°E 105.39' 8" Maple N30°E 89.73' 10" Maple	
Act 132 Survey by: Delmer E. Porter, #15410, Feb.11, 1976, Survey#24-76 File#34R2072 Lib. Pg.	Same as above	
Act 74 filing by: Delmer E. Porter, #15410, Sept.14, 1978, Page 295, Corner Recordation	Fd. Axle Shaft N30°E 89.73' 10" Maple N55°E 105.39' 8" Maple Due South 33.94' Fe. Cor. Left Axle Shaft in Mon. Box Same Witnesses	Presque Isle County Remonumentation Project
Act 132 Survey by: Delmer E. Porter, #15410, Sept.25, 1980 Survey#114-80 File#34R2080 Lib. 241, Pg. 195	Same as above	
Act 132 Survey by: Delmer E. Porter, #15410, May 2, 1989 Survey#37-89 File#34R2220 Unrecorded	1/2" Rod in Mon. Box N30°E 89.73' 10" Maple N55°E 105.39' 8" Maple South 33.94' Fe. Cor.	#3-
Remonumentation Sept. 13, 1993	Fd. 1/2" Rod & Cap #15410 in Mon. Box N56°E 105.74' 22" Maple Left Same N32°E 69.73' 10" Elm N56°E 105.74' 22" Maple N77°E 112.36' 18" Elm S71°E 183.93' 12" Spruce	

Survey &
Monumentation

JAN 22 2001

SECTION