

1993

COMMISSION

LAND CORNER RECORDATION CERTIFICATE
Filing Requirement of Act 74, Mich. P.A. 1970

PRESQUE ISLE COUNTY
RECORDED

93 DEC 22 AM 10:02

Janet M. Lamb
REGISTER OF DEEDS

For corners in

PRESQUE ISLE
(County)

Located In:

Corner Code #

- 1. Public Land Survey T 34N 2E E-13
- T _____ R _____
- T _____ R _____
- T _____ R _____
- 2. Property Controlling S _____ T _____ R _____
- in Section S _____ T _____ R _____
- 3. Miscellaneous S _____ T _____ R _____
- Property in Sec. S _____ T _____ R _____

Register of Deeds Stamp & File Number

4. Lot No. _____, Recorded Plat _____

5. Private Claims _____

	A	B	C	D	E	F	G	H	I	J	K	L	M
2	6	5	4	3	2	1							
3													
4	7	8	9	10	11	12							
5													
6	18	17	16	15	14	13							
7													
8	19	20	21	22	23	24							
9													
10	30	29	28	27	26	25							
11													
12	31	32	33	34	35	36							
13													

I, DELMER E. PORTER, in a field survey on DEC. 8, 19 93, do hereby certify that under requirements of P.A. 74, Michigan P.A. of 1970, the corner points mentioned in lines 1 and 2 above were in conformance with regulations and rules therefore as required in the current manual of survey instructions of the United States Department of the Interior, Bureau of Land Management or by a decree of a Court of Law and/or that the corner points mentioned in lines 3, 4 and 5 above were in conformance with the rules of the Michigan Board of Land Surveyors or by a Decree of a Court of Law; established, re-established, monumented, re-monumented, recovered, found as expressed below:

NOTE: Not more than 4 corners, all in the same town and range, may be recorded on this certificate.

A. Description of original monument and accessories and/or subsequent restoration:

E-13 GLO NOTES
JULY 14, 1855
W. PINE 14" N 35° W 20 lks.
ELM 16" N 56° E 28 lks.

E-13
P.A. 74 FILING BY RONALD R. BISCHER
L.S. 22428 AUG. 19, 1976 PAGE 151
LAND CORNER RECORD
SET 1/2" ROD & CAP #15410 BY SINGLE PROPORTION

B. Description of corner evidence found and/or method applied in restoring or reestablishing corner:

E-13
DEC. 8, 1993
FOUND 4" CONCRETE MONUMENT WITH BRASS CAP
FENCE CORNERS IN POOR CONDITION AND HAVE BEEN REPLACED

WITNESSES


S 36° W 98.83' 4" BALSAM
N 86° W 17.84' FE. CORNER
N 32° W 33.17' FE. CORNER
E-13 P.A. 74 FILING BY
DELMER E. PORTER LS #15410
NOV. 6, 1978, PAGE 385
LAND CORNER RECORDS. REPLACE
1/2" ROD WITH 4" CONC. MON. &
BRASS CAP. SAME WITNESS AS
ABOVE.

Ratified by Peer Group
in accordance with P.A. 345

Chairman *Delmer E. Porter*
Date December 18, 1993

C. Description of monument for corner and accessories established to perpetuate locating the position of the corner:

E-13
4" CONCRETE MONUMENT WITH BRASS CAP
S 85° W 116.88' POWER POLE
S 58° E 64.31' BRACE POLE
S 79° E 83.98' FENCE CORNER
N 13° W 81.55' FENCE CORNER
* NAILS AND TAGS #15410 USED IN WITNESSES
PORTER'S SURVEY, P.C.

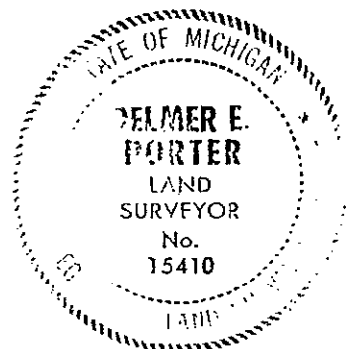

Signed by *Delmer E. Porter*
Surveyor's Michigan License No. 15410

Date Dec 20, 1993

CORNER HISTORY RESEARCH SHEET

E-13

T34N,R2E ALLIS TOWNSHIP-NORTH PART,
PRESQUE ISLE COUNTY, MICHIGAN.

ACTIVITY MONUMENT & ACCESSORIES - COMMENTS

GLO Survey
July 14, 1855

W. Pine 14" N35°W 20 Links
Elm 16" N56°E 28 Links

Act 74 filing by
Ronald R. Bischer #22428
Aug. 19, 1976, Page 151
Corner Recordation

Set 1/2 Rod & Cap By
Single Proportion
S36°W 98.83' 4" Balsam
N86°W 17.84' FE Cor.
N32°W 33.17' FE Cor.

Act 74 filing by
Delmer E. Porter #15410
Nov. 6, 1978, Page 385
Corner Recordation

Found 1/2" Rod & Cap #15410
N32°W 33.17' FE Cor.
N86°W 17.84' FE Cor. Presque Isle
S36°W 98.83' 4" Balsam County
Replaced w/P.I. Co. Remon.
Remon. Project
Conc. Mon. & Brass Cap
Same Witnesses

Presque Isle
Remonumentation
Dec. 8, 1993

FD. Conc. Mon. with brass cap
FD. fence corners but were in
poor condition, replaced
S85°W 116.88' P. Pole
S58°E 64.31' Brace Pole
S79°E 83.98' Fence Cor.
N13°W 81.55' Fence Cor.

#5