

93 DEC 20 PM 4: 49

Janet M. Lamb
REGISTER OF DEEDS

LAND CORNER RECORDATION CERTIFICATE
Filing Requirement of Act 74, Mich. P.A. 1970

For corners in
PRESQUE ISLE
(County)

Located In: Corner Code #

1. Public Land Survey	T	34N	R	2E	F-1
	T		R		
	T		R		
	T		R		
2. Property Controlling in Section	S		T	R	
	S		T	R	
3. Miscellaneous Property in Sec.	S		T	R	
	S		T	R	

LIBER 307 PAGE 914

Register of Deeds Stamp & File Number

4. Lot No. _____, Recorded Plat _____
5. Private Claims _____

	A	B	C	D	E	F	G	H	I	J	K	L	M
2	6			5		4		3		2		1	
3													
4	7			8		9		10		11		12	
5													
6	10			17		16		15		14		13	
7													
8	19			20		21		22		23		24	
9													
10	30			29		28		27		26		25	
11													
12	31			32		33		34		35		36	
13													

I, Ronald R. Bischer, in a field survey on September 7, 19 93, do hereby certify that under requirements of P.A. 74, Michigan P.A. of 1970, the corner points mentioned in lines 1 and 2 above were in conformance with regulations and rules therefore as required in the current manual of survey instructions of the United States Department of the Interior, Bureau of Land Management or by a decree of a Court of Law and/or that the corner points mentioned in lines 3, 4 and 5 above were in conformance with the rules of the Michigan Board of Land Surveyors or by a Decree of a Court of Law; established, re-established, monumented, re-monumented, recovered, found as expressed below:

NOTE: Not more than 4 corners, all in the same town and range, may be recorded on this certificate.

A. Description of original monument and accessories and/or subsequent restoration:

F-1


Corner not set in Original Survey
1973 - Delmar E. Porter
N20°E 16.09' 3" Willow in clump
S50°E 50.10' Fence post
S60°W 62.42' Fence post
Recorded on Page 30, Land
Recordation, October 25, 1973.

1978 - Delmar E. Porter (Remonumentation)
Found 1" Pipe, Replaced pipe with concrete
monument w/brass cap
Used three Porter witnesses from 1973.
Not recorded.

B. Description of corner evidence found and/or method applied in restoring or reestablishing corner:

F-1

Found Presque Isle County Remonumentation Monument
N38°E 16.12' 4" Willow

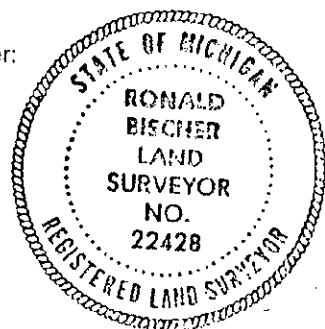

SURVEY &
REMONUMENTATION

1993

COMMISSION

C. Description of monument for corner and accessories established to perpetuate locating the position of the corner:

F-1

Presque Isle County Remonumentation Monument
N38°E 16.12' 4" Willow
N53°E 6.96' 4" Willow
N85°W 16.43' 6" Aspen
Due S 32.95' Fence Corner

Ratified by Peer Group
in accordance with P.A. 345
Chairman *Delmar E. Porter*
Date December 7, 1993

*Witness tags and nails used.

Signed by Ronald R. Bischer

Date 12-13-93

Surveyor's Michigan License No. 22428

F-1 Corner, Section 4, Township 34N Range 2E

<u>Activity</u>	<u>Monument & Accessories</u>	<u>Notes</u>
Corner not set in Original Survey.		
1973 Delmar E. Porter #15410	Found 1" Pipe Set three witnesses. Recorded on Page 30, Land Recordation, October 25, 1973.	
1978 Remonumentation Delmar E. Porter #15410	Found 1" pipe, replaced w/Concrete monument w/Brass cap Three witnesses (not recorded)	
1993 Remonumentation Ronald R. Bischer #22428	Found Concrete monument w/Brass cap N38°E 16.12' 4" Willow found nail w/tag #15410 N53°E 6.96' 4" Willow set nail w/tag #22428 N85°W 16.43' 6" Aspen set nail w/tag #22428 South 32.95' Fence corner set nail w/tag #22428	

45.