

PRESQUE ISLE COUNTY
RECORDED

93 DEC 20 PM 14:49

Janet M. Lamb
REGISTER OF DEEDS

LAND CORNER RECORDATION CERTIFICATE
Filing Requirement of Act 74, Mich. P.A. 1970

For corners in

<u>PRESQUE ISLE</u> <small>(County)</small>	Located In:	Corner Code #
1. Public Land Survey	T <u>34N</u> R <u>2E</u>	<u>F-5</u>
	T _____ R _____	_____
	T _____ R _____	_____
	T _____ R _____	_____
2. Property Controlling in Section	S _____ T _____ R _____	_____
	S _____ T _____ R _____	_____
3. Miscellaneous Property in Sec.	S _____ T _____ R _____	_____
	S _____ T _____ R _____	_____

LIBER 307 PAGE 918

Register of Deeds Stamp & File Number

4. Lot No. _____, Recorded Plat _____
5. Private Claims _____

A	B	C	D	E	F	G	H	I	J	K	L
2	6	5	4	3	2	1					
3											
4	7	8	9	10	11	12					
5											
6	18	17	16	15	14	13					
7											
8	19	20	21	22	23	24					
9											
10	30	29	28	27	26	25					
11											
12	31	32	33	34	35	36					
13											

I, Ronald R. Bischer, in a field survey on September 14, 19 93, do hereby certify that under requirements of P.A. 74, Michigan P.A. of 1970, the corner points mentioned in lines 1 and 2 above were in conformance with regulations and rules therefore as required in the current manual of survey instructions of the United States Department of the Interior, Bureau of Land Management or by a decree of a Court of Law and/or that the corner points mentioned in lines 3, 4 and 5 above were in conformance with the rules of the Michigan Board of Land Surveyors or by a Decree of a Court of Law; established, re-established, monumented, re-monumented, recovered, found as expressed below:


NOTE: Not more than 4 corners, all in the same town and range, may be recorded on this certificate.

A. Description of original monument and accessories and/or subsequent restoration:

F-5
1855 Resurvey - Geo. H. Cannon (July) S49°W 39.50' Fence corner
Set Wood Post S02°E 36.36' Fence corner
15" Cedar N48°E 17 links Recorded on Page 82, Land
14" Cedar S22°W 7½ links Recordation, August 18, 1975.
1975 - Delmar E. Porter
Set ½" Rod by single proportion
N35°W 44.55' Fence corner

B. Description of corner evidence found and/or method applied in restoring or reestablishing corner:

F-5
Found ½" Rod and Cap #15410
N38°W 45.05' Fence corner
S49°W 40.12' Fence corner

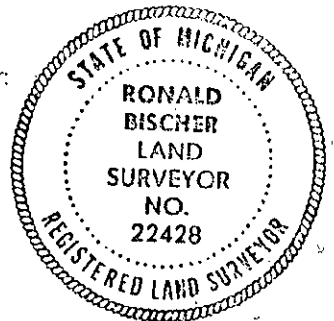

SURVEY &
REMONUMENTATION

1993

COMMISSION

C. Description of monument for corner and accessories established to perpetuate locating the position of the corner:

F-5
½" Rod and Cap #15410
N38°W 45.05' Fence corner
S49°W 40.12' Fence corner
S43°W 52.27' Power pole
S34°E 40.91' Fence corner

*Witness tags and nails used.

Ratified by Peer Group
in accordance with P.A. 345
Chairman *Delmar E. Porter*
Date December 7, 1993

Signed by Ronald R. Bischer

Date 12-13-93

Surveyor's Michigan License No. 22428

F-5 Corner, Section 9, 16, Township 34N Range 2E

<u>Activity</u>	<u>Monument & Accessories</u>	<u>Notes</u>
1855 Resurvey Geo. H. Cannon	Set Wood Post 15" Cedar N48°E 17 links 14" Cedar S22°W 7½ links	
1975 Delmar E. Porter #15410	Set ½" rod by Single Proportion Set three witnesses. Recorded on Page 82, Land Recordation, August 18, 1975.	
1993 Remonumentation Ronald R. Bischer #22428	Found ½" Rod & Cap #15410 N38°W 45.05' Fence Corner found nail w/tag #15410 S49°W 40.12' Fence Corner found nail w/tag #15410 S43°W 52.27' Power Pole set nail w/tag #22428 S34°E 40.91' Fence Corner set nail w/tag #22428	

AS.