

1993

PRESQUE ISLE COUNTY
RECORDED

93 DEC 22 AM 10:02

COMMISSION

LAND CORNER RECORDATION CERTIFICATE
Filing Requirement of Act 74, Mich. P.A. 1970

Janet M. Lamb
REGISTER OF DEEDS

For corners in

<u>Presque Isle</u> <small>(County)</small>	Located In:	Corner Code #
1. Public Land Survey	T <u>34N</u> R <u>2E</u>	<u>F-11</u>
	T _____ R _____	_____
	T _____ R _____	_____
	T _____ R _____	_____
2. Property Controlling in Section	S _____ T _____ R _____	_____
	S _____ T _____ R _____	_____
3. Miscellaneous Property in Sec.	S _____ T _____ R _____	_____
	S _____ T _____ R _____	_____

Register of Deeds Stamp & File Number

4. Lot No. _____, Recorded Plat _____
5. Private Claims _____

I, Delmer E. Porter in a field survey on Dec. 9, 1993, do hereby certify that under requirements of P.A. 74, Michigan P.A. of 1970, the corner points mentioned in lines 1 and 2 above were in conformance with regulations and rules therefore as required in the current manual of survey instructions of the United States Department of the Interior, Bureau of Land Management or by a decree of a Court of Law and/or that the corner points mentioned in lines 3, 4 and 5 above were in conformance with the rules of the Michigan Board of Land Surveyors or by a Decree of a Court of Law; established, re-established, monumented, re-monumented, recovered, found as expressed below:

NOTE: Not more than 4 corners, all in the same town and range, may be recorded on this certificate.

A	B	C	D	E	F	G	H	I	J	K	L	M
2	6	5	4	3	2	1						
3												
4	7	8	9	10	11	12						
5												
6	18	17	16	15	14	13						
7												
8	19	20	21	22	23	24						
9												
10	30	29	28	27	26	25						
11												
12	31	32	33	34	35	36						
13												

A. Description of original monument and accessories and/or subsequent restoration:

F-11 GLO Notes July 16, 1855 Tamarack 11" S72° E 30 Links Tamarack 10" North 27½ Links F-11 PA 74 filing by Ronald R. Bischer LS #22428, March 17, 1981, Land Corner Records	Found Stake Point & Tamarack Stub North 18.1' with Chest blaze and foot blaze visible and 3 witnesses not of record Replaced with ½" rod & Cap #15410 N38° W 30.57' 10" Cedar S56° W 9.76' 10" Cedar S47° E 24.79' 12" Cedar
--	---


B. Description of corner evidence found and/or method applied in restoring or reestablishing corner:

F-11 Dec. 9, 1993
Found ½" Rod & Cap #15410
By original Stake Point
S56° W 9.91' 10" Cedar
N36° W 30.72' 10" Cedar
S46° E 24.85' 13" Cedar

Ratified by Peer Group
in accordance with P.A. 345
Chairman Delmer E. Porter
Date December 14, 1993

C. Description of monument for corner and accessories established to perpetuate locating the position of the corner:

F-11
1/2" Rod & Cap #15410
S56° W 9.91' 10" Cedar
N36° W 30.72' 10" Cedar
S46° E 24.85' 13" CEDAR
N 70° E 15.25' 3" BALSAM
* NAILS & TAGS #15410 USED IN WITNESSES
PORTER'S SURVEY, P.C.

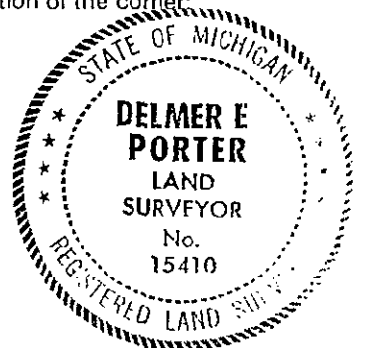

Signed by Delmer E. Porter

Date Dec 20, 1993

Surveyor's Michigan License No. 15410

CORNER HISTORY RESEARCH SHEET

F-11

T34N,R2E, ALLIS TOWNSHIP-NORTH PART,
PRESQUE ISLE COUNTY, MICHIGAN.

ACTIVITY MONUMENT & ACCESSORIES - COMMENTS

GLO Survey
July 16, 1855

Tamarack 11" S72°E 30 Links (19.8')
Tamarack 10" North 27 1/2 Links (18.15')

Act 74 filing by:
Ronald R. Bischer
#22428, Mar.17, 1981

Fd. Stake Point
Tamarack Stub North 18.1'
w/Chest Blaze & Foot Blaze visible
3 other Witness Trees - not of record
Replaced w/ 1/2" Rod & Cap
N38°W 30.57' 10" Cedar
S56°W 9.76' 10" Cedar
S47°E 24.79' 12" Cedar

Act 132 Survey by
Delmer E. Porter
#15410, May 11, 1986,
Survey#21-86
File#34R2187
Lib.279, Pg.710

Fd. the 1/2" Rod
and above Witnesses

Presque Isle
Remonumentation
Dec. 9, 1993

Found 1/2" Rod & Cap #15410
By original stake point
and above witnesses
S56°W 9.91' 10" Cedar
N36°W 30.72' 10" Cedar
S46°E 24.85' 13" Cedar
N70°E 15.25' 3" Balsam

