

1993

COMMISSION

LAND CORNER RECORDATION CERTIFICATE
Filing Requirement of Act 74, Mich. P.A. 1970

PRESQUE ISLE COUNTY
RECORDED

93 DEC 22 AM 10:02

Janet M. Lamb
REGISTER OF DEEDS

For corners in

<u>PRESQUE ISLE</u> <small>(County)</small>	Located In:	Corner Code #
1. Public Land Survey	T <u>34N</u> R <u>2E</u>	<u>F-13</u>
	T _____ R _____	_____
	T _____ R _____	_____
	T _____ R _____	_____
2. Property Controlling in Section	S _____ T _____ R _____	_____
	S _____ T _____ R _____	_____
3. Miscellaneous Property in Sec.	S _____ T _____ R _____	_____
	S _____ T _____ R _____	_____

Register of Deeds Stamp & File Number

4. Lot No. _____, Recorded Plat _____
5. Private Claims _____

	A	B	C	D	E	F	G	H	I	J	K	L	M
2	6		5		4		3		2		1		
3													
4	7		8		9		10		11		12		
5													
6	18		17		16		15		14		13		
7													
8	19		20		21		22		23		24		
9													
10	30		29		28		27		26		25		
11													
12	31		32		33		34		35		36		
13													

I, DELMER E. PORTER a field survey on DEC. 8, 19 93
do hereby certify that under requirements of P.A. 74, Michigan P.A. of 1970, the corner points mentioned in lines 1 and 2 above were in conformance with regulations and rules therefore as required in the current manual of survey instructions of the United States Department of the Interior, Bureau of Land Management or by a decree of a Court of Law and/or that the corner points mentioned in lines 3, 4 and 5 above were in conformance with the rules of the Michigan Board of Land Surveyors or by a Decree of a Court of Law; established, re-established, monumented, re-monumented, recovered, found as expressed below:

NOTE: Not more than 4 corners, all in the same town and range, may be recorded on this certificate.

A. Description of original monument and accessories and/or subsequent restoration:

F-13 GLO NOTES
JULY 14, 1855
CEDAR 7" N 60° W 4½ lks.
CEDAR 8" N 58° 12 lks.

WITNESSES

S 47° W 11.74' 7" CEDAR
N 02° W 23.25' 8" CEDAR
S 12° E 16.66' 8" CEDAR
F-13 P.A. 74 FILING BY DELMER E. PORTER
LLS #15410 NOV. 6, 1978 PAGE 385
LAND CORNER RECORDS. REPLACED 1" PIPE
WITH 4" CONCRETE MONUMENT
WITNESSES SAME AS ABOVE


B. Description of corner evidence found and/or method applied in restoring or reestablishing corner:

F-13
DEC. 8, 1993
FOUND 4" CONCRETE MONUMENT WITH BRASS CAP
N 02° E 22.98' 10" CEDAR
S 12° E 17.06' 8" CEDAR
S 47° W 12.09' 8" CEDAR

Ratified by Peer Group
in accordance with P.A. 348
Chairman *Delmer E. Porter*
Date December 18, 1993

C. Description of monument for corner and accessories established to perpetuate locating the position of the corner:

F-13
4" CONCRETE MONUMENT WITH BRASS CAP
N 02° E 22.98' 10" CEDAR
N 90° E 26.69' 7" CEDAR
S 12° E 17.06' 8" CEDAR
S 47° W 12.09' 8" CEDAR
* NAILS AND TAGS #15410 USED IN WITNESSES
PORTER'S SURVEY, P.C.

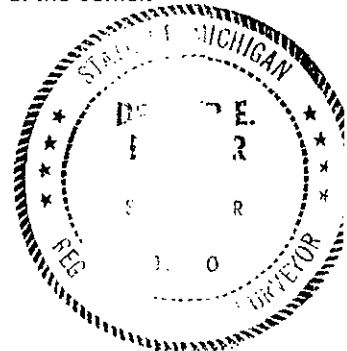

Signed by *Delmer E. Porter*
Surveyor's Michigan License No. 15410

Date Dec 20, 1993

CORNER HISTORY RESEARCH SHEET

F-13

T34N,R2E ALLIS TOWNSHIP-NORTH PART,
PRESQUE ISLE COUNTY, MICHIGAN.

ACTIVITY MONUMENT & ACCESSORIES - COMMENTS

GLO Survey
July 14, 1855

Cedar 7" N60°W 4 1/2 Links
Cedar 8" N58° 12 Links

Act 74 filing by
Ronald R. Bischer #22428
Aug. 19, 1976, Page 151
Corner Recordation

Found 1" Pipe
Left Same
S47°W 11.74' 7" Cedar
N02°W 23.25' 8" Cedar
S12°E 16.66' 8" Cedar

Act 74 filing by
Delmer E Porter #15410
Nov. 6, 1978, Page 385
Corner Recordation

Found 1" Pipe
N02°W 23.25' 8" Cedar
S47°W 11.76' 7" Cedar
S12°E 16.66' 8" Cedar Presque Isle
Replaced w/P.I. Co. Remon. County
Conc. Mon. & Brass Cap Remon.
Same Witnesses Project

Presque Isle
Remonumentation
Dec. 8, 1993

FD. Conc. Mon. with Brass Cap
and same witnesses as above
N02°E 22.98' 10" Cedar
N90°E 26.69' 7" Cedar
S12°E 17.06' 8" Cedar
S47°W 12.09' 8" Cedar

Handwritten mark: a large 'X' with a flourish underneath.