

PRESQUE ISLE COUNTY  
RECORDED

93 DEC 20 PM 4:49

*Janet M. Sand*  
REGISTER OF DEEDS

LAND CORNER RECORDATION CERTIFICATE  
Filing Requirement of Act 74, Mich. P.A. 1970

For corners in

PRESQUE ISLE  
(County)

Located In:

Corner Code #

1. Public Land Survey	T	<u>34N</u>	R	<u>2E</u>	<u>G-1</u>
	T	_____	R	_____	_____
	T	_____	R	_____	_____
	T	_____	R	_____	_____
2. Property Controlling in Section	S	_____	T	_____	_____
	S	_____	T	_____	_____
3. Miscellaneous Property in Sec.	S	_____	T	_____	_____
	S	_____	T	_____	_____

LIBER **307** PAGE **922**

Register of Deeds Stamp & File Number

4. Lot No. \_\_\_\_\_, Recorded Plat \_\_\_\_\_  
5. Private Claims \_\_\_\_\_

	A	B	C	D	E	F	G	H	I	J	K	L
2	6	5	4	3	2							
3												
4	7	8	9	10	11	12						
5												
6	18	17	16	15	14	13						
7												
8	19	20	21	22	23	24						
9												
10	30	29	28	27	26	25						
11												
12	31	32	33	34	35	36						
13												

I, Ronald R. Bischer, in a field survey on September 14, 19 93, do hereby certify that under requirements of P.A. 74, Michigan P.A. of 1970, the corner points mentioned in lines 1 and 2 above were in conformance with regulations and rules therefore as required in the current manual of survey instructions of the United States Department of the Interior, Bureau of Land Management or by a decree of a Court of Law and/or that the corner points mentioned in lines 3, 4 and 5 above were in conformance with the rules of the Michigan Board of Land Surveyors or by a Decree of a Court of Law; established, re-established, monumented, re-monumented, recovered, found as expressed below:

**NOTE: Not more than 4 corners, all in the same town and range, may be recorded on this certificate.**

A. Description of original monument and accessories and/or subsequent restoration:

G-1  
 1855 Resurvey - Geo. H. Cannon (July) N70°W 144.85' Power pole  
 Set Wood Post S70°W 55.30' Fence corner  
 7" Ironwood S53°W 44 links S35°W 96.35' Fence post  
 22" Sugar S34°E 32 links Recorded on Page 375, Land  
 1978 - Delmar E. Porter (Remonumentation) Recordation, November 29, 1978.  
 Found 1" Rod, replaced with Concrete  
 Monument w/Brass Cap


B. Description of corner evidence found and/or method applied in restoring or reestablishing corner:

G-1  
 Found Presque Isle County Remonumentation Monument  
 N73°W 144.68' Power pole

SURVEY &  
REMONUMENTATION

1993

COMMISSION

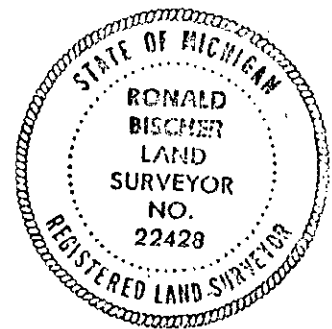

C. Description of monument for corner and accessories established to perpetuate locating the position of the corner:

G-1  
 Presque Isle County Remonumentation Monument  
 N73°W 144.68' Power pole  
 S59°W 56.38' Fence corner  
 S23°E 59.11' 4" Apple tree  
 S33°W 84.88' Fence post

Ratified by Peer Group  
in accordance with P.A. 345

Chairman *Delmar E. Porter*

Date December 7, 1993

\*Witness tags and nails used.

Signed by Ronald R. Bischer

Date 12-13-93

Surveyor's Michigan License No. 22428

## CORNER HISTORY RESEARCH SHEET

G-1 Corner, Section 3,4, Township 34N Range 2E

<u>Activity</u>	<u>Monument &amp; Accessories</u>	<u>Notes</u>
1855 Resurvey Geo. H. Cannon	Set Wood Post 7" Ironwood S53°W 44 links 22" Sugar S34°E 32 links	
1978 Remonumentation Delmar E. Porter #15410	Found 1" Rod, replaced with Concrete monument w/brass Cap three witnesses	1" Rod assumed to be set by David Bowen at an unknown date
1993 Remonumentation Ronald R. Bischer #22428	Found concrete monument w/ Brass cap N73°W 144.68' Power Pole found nail w/tag #15410 S59°W 56.38' Fence corner set nail w/tag #22428 S23°E 59.11' 4" Apple Tree set nail w/tag #22428 S33°W 84.88' Fence post set nail w/tag #22428	

# 3.