

PRESQUE ISLE COUNTY
RECORDED

93 DEC 20 PH 4:19

LAND CORNER RECORDATION CERTIFICATE
Filing Requirement of Act 74, Mich. P.A. 1970

Janet M. Lamb
REGISTER OF DEEDS

For corners in

PRESQUE ISLE
(County)

Located In:

Corner Code #

- 1. Public Land Survey T 34N R 2E G-2
 T _____ R _____
 T _____ R _____
 T _____ R _____
- 2. Property Controlling S _____ T _____ R _____
 in Section S _____ T _____ R _____
- 3. Miscellaneous S _____ T _____ R _____
 Property in Sec. S _____ T _____ R _____

LIBER **307** PAGE **924**

Register of Deeds Stamp & File Number

- 4. Lot No. _____, Recorded Plat _____
- 5. Private Claims _____

	A	B	C	D	E	F	G	H	I	J	K	L	M
2	6	5	4	3	2	1							
3													
4	7	8	9	10	11	12							
5													
6	18	17	16	15	14	13							
7													
8	19	20	21	22	23	24							
9													
10	30	29	28	27	26	25							
11													
12	31	32	33	34	35	36							
13													

I, Ronald R. Bischer, in a field survey on September 14, 19 93, do hereby certify that under requirements of P.A. 74, Michigan P.A. of 1970, the corner points mentioned in lines 1 and 2 above were in conformance with regulations and rules theretofore as required in the current manual of survey instructions of the United States Department of the Interior, Bureau of Land Management or by a decree of a Court of Law and/or that the corner points mentioned in lines 3, 4 and 5 above were in conformance with the rules of the Michigan Board of Land Surveyors or by a Decree of a Court of Law; established, re-established, monumented, re-monumented, recovered, found as expressed below:

NOTE: Not more than 4 corners, all in the same town and range, may be recorded on this certificate.

A. Description of original monument and accessories and/or subsequent restoration:

G-2

1855 Resurvey - Geo. H. Cannon (July) Due E 27.26' Corner fence post
 Set Wood Post SW 35.78' Fence post
 15" Beech S88°W 48 links S50°E 38.00' Fence post
 20" Hemlock N69°E 9½ links Recorded on Page 30, Land
 1973 - Delmar E. Porter Recordation, October 25, 1973.
 Found 1" Bar (Set by D. Bowen at an
 unknown date)

B. Description of corner evidence found and/or method applied in restoring or reestablishing corner:


G-2

Found 1" Bar badly bent
 East 27.52' Fence corner
 Replaced 1" Bar with ½" Rod and Cap #22428.

SURVEY &
REMONUMENTATION

1993

COMMISSION

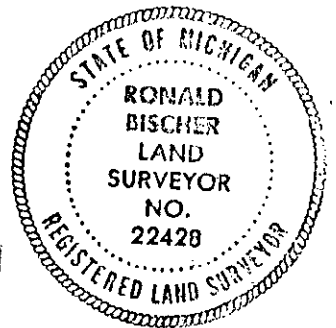

C. Description of monument for corner and accessories established to perpetuate locating the position of the corner:

G-2

½" Rod and Cap #22428
 East 27.52' Fence corner
 S38°W 50.35' 4" Apple tree
 S81°W 37.96' 4" Apple tree
 S42°E 111.55' 4" Balsam

Ratified by Peer Group
 in accordance with P.A. 345
 Chairman Delmar E. Porter
 Date December 7, 1993

*Witness tags and nails used.

Signed by Ronald R. Bischer

Date 12-13-93

Surveyor's Michigan License No. 22428

G-2 Corner, Section 3, 4, Township 34N Range 2E

<u>Activity</u>	<u>Monument & Accessories</u>	<u>Notes</u>
1855 Resurvey Geo. H. Cannon	Set Wood Post 15" Beech S88°W 48 links 20" Hemlock N69°E 9½ links	:
1973 Delmar E. Porter #15410	Found 1" Bar Found 2 witnesses Recorded on Page 30, Land Recordation, October 25, 1973.	1" Bar set by David Bowen at an unknown date.
1993 Remonumentation Ronald R. Bischer #22428	Found 1" Bar badly bent, Replaced w/½" Rod & Cap #22428 East 27.52' Fence corner found nail w/tag #15410 S38°W 50.35' 4" Apple Tree set nail w/tag #22428 S81°W 37.96' 4" Apple Tree set nail w/tag #22428 S42°E 111.55' 4" Balsam set nail w/tag #22428	

3.