

LAND CORNER RECORDATION CERTIFICATE  
Filing Requirement of Act 74, Mich. P.A. 1970

*Janet M. Lamb*  
REGISTER OF DEEDS

For corners in

<u>PRESQUE ISLE</u> (County)	Located In:	Corner Code #
1. Public Land Survey	T <u>34N</u> R <u>2E</u>	<u>G-4</u>
	T _____ R _____	_____
	T _____ R _____	_____
	T _____ R _____	_____
2. Property Controlling in Section	S _____ T _____ R _____	_____
	S _____ T _____ R _____	_____
3. Miscellaneous Property in Sec.	S _____ T _____ R _____	_____
	S _____ T _____ R _____	_____

LIBER 307 PAGE 928

Register of Deeds Stamp & File Number

4. Lot No. \_\_\_\_\_, Recorded Plat \_\_\_\_\_  
5. Private Claims \_\_\_\_\_

A	B	C	D	E	F	G	H	I	J	K	L
2	6	5	4	3	2						
3											
4	7	8	9	10	11						
5											
6	18	17	16	15	14						
7											
8	19	20	21	22	23	24					
9											
10	30	29	28	27	26	25					
11											
12	31	32	33	34	35	36					
13											

I, Ronald R. Bischer, in a field survey on September 14, 19 93, do hereby certify that under requirements of P.A. 74, Michigan P.A. of 1970, the corner points mentioned in lines 1 and 2 above were in conformance with regulations and rules therefore as required in the current manual of survey instructions of the United States Department of the Interior, Bureau of Land Management or by a decree of a Court of Law and/or that the corner points mentioned in lines 3, 4 and 5 above were in conformance with the rules of the Michigan Board of Land Surveyors or by a Decree of a Court of Law; established, re-established, monumented, re-monumented, recovered, found as expressed below:

**NOTE: Not more than 4 corners, all in the same town and range, may be recorded on this certificate.**


A. Description of original monument and accessories and/or subsequent restoration:

G-4  
1855 Resurvey - Geo. H. Cannon (July) S83°30'E 33.29' Fence corner  
Set Wood Post Recorded on Page 82, Land  
14" Black Ash N58°E 20 links Recordation, August 18, 1975.  
12" Sugar S63°W 11 links  
1975 - Delmar E. Porter  
Found small boat spike  
S79°30'W 34.71' Fence post

B. Description of corner evidence found and/or method applied in restoring or reestablishing corner:

G-4  
Found small boat spike located by Porter in 1975  
S77°W 34.60' Fence post  
S85°E 34.30' Fence corner

Replaced boat spike with 1/2" Rod & Cap #22428.

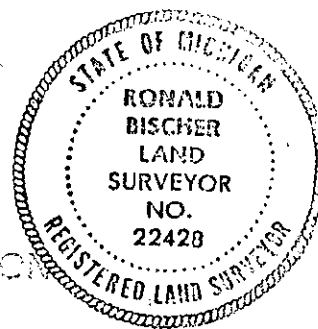

SURVEY &  
MONUMENTATION

1993

COMMISSION

C. Description of monument for corner and accessories established to perpetuate locating the position of the corner:

G-4  
1/2" Rod and Cap #22428  
S77°W 34.60' Fence post  
S85°E 34.30' Fence corner  
S58°E 78.73' 8" Aspen  
S78°W 66.01' 5" White Pine

Ratified by Peer Group  
in accordance with P.A. 345

Chairman *Delmar E. Porter*  
Date December 7, 1993

\*Witness tags and nails used.

Signed by Ronald R. Bischer Date 12-13-93

Surveyor's Michigan License No. 22428

G-4 Corner, Section 9 &amp; 10, Township 34N Range 2E

<u>Activity</u>	<u>Monument &amp; Accessories</u>	<u>Notes</u>
1855 Resurvey Geo. H. Cannon	Set Wood Post 14" Black Ash N58°E 20 links 12" Sugar S63°W 11 links	
1975 Delmar E. Porter #15410	Found small Boat Spike Set 2 witnesses. Recorded on Page 82, Land Recordation, August 18, 1975	
1993 Remonumentation Ronald R. Bischer #22428	Found small Boat Spike located by Porter in 1975 Replaced Boat Spike w/1/2" Rod & Cap #22428 S77°W 34.60' Fence post found nail w/tag #15410 S85°E 34.30' Fence corner found nail w/tag #15410 S58°E 78.73' 8" Aspen set nail w/tag #22428 S78°W 66.01' 5" White Pine set nail w/tag #22428	

#3