

PRESQUE ISLE COUNTY
RECORDED

93 DEC 20 PM 4:49

Janet M. Lamb
REGISTER OF DEEDS

LAND CORNER RECORDATION CERTIFICATE
Filing Requirement of Act 74, Mich. P.A. 1970

For corners in

<u>PRESQUE ISLE</u> (County)	Located In:	Corner Code #
1. Public Land Survey	T <u>34N</u> R <u>2E</u>	<u>G-5</u>
	T _____ R _____	_____
	T _____ R _____	_____
	T _____ R _____	_____
2. Property Controlling in Section	S _____ T _____ R _____	_____
	S _____ T _____ R _____	_____
3. Miscellaneous Property in Sec.	S _____ T _____ R _____	_____
	S _____ T _____ R _____	_____

LIBER 307 PAGE 930

Register of Deeds Stamp & File Number

4. Lot No. _____, Recorded Plat _____
 5. Private Claims _____

	A	B	C	D	E	F	G	H	I	J	K	L
2	6		5		4		3		2		1	
3												
4	7		8		9		10		11		12	
5							●					
6	18		17		16		15		14		13	
7												
8	19		20		21		22		23		24	
9												
10	30		29		28		27		26		25	
11												
12	31		32		33		34		35		36	
13												

I, Ronald R. Bischer, in a field survey on September 14, 19 93, do hereby certify that under requirements of P.A. 74, Michigan P.A. of 1970, the corner points mentioned in lines 1 and 2 above were in conformance with regulations and rules therefore as required in the current manual of survey instructions of the United States Department of the Interior, Bureau of Land Management or by a decree of a Court of Law and/or that the corner points mentioned in lines 3, 4 and 5 above were in conformance with the rules of the Michigan Board of Land Surveyors or by a Decree of a Court of Law; established, re-established, monumented, re-monumented, recovered, found as expressed below:

NOTE: Not more than 4 corners, all in the same town and range, may be recorded on this certificate.


A. Description of original monument and accessories and/or subsequent restoration:

G-5
 1855 Resurvey - Geo. H. Cannon (July) S43°E 51.83' Power pole
 Set Wood Post S45°W 60.49' Fence corner
 18" Sugar N20°E 30½ links Recorded on Page 82, Land
 28" Sugar S12°W 38 links Recordation, August 18, 1975.
 1975 - Delmar E. Porter
 Found 3/4" Pipe
 N49°30'E 46.95' Fence corner

B. Description of corner evidence found and/or method applied in restoring or reestablishing corner:

G-5
 Found 3/4" Pipe
 N46°E 47.06' Fence corner
 S43°E 51.56' Power pole
 Raised 3/4" Pipe with ½" Rod and Cap #22428.

SURVEY &
 REMONUMENTATION
 1993
 COMMISSION

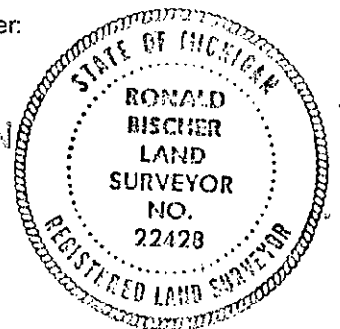

C. Description of monument for corner and accessories established to perpetuate locating the position of the corner:

G-5
 ½" Rod and Cap #22428 in 3/4" Pipe
 N46°E 47.06' Fence corner
 S43°E 51.56' Power pole
 N50°W 51.07' Top of telephone cable box
 N39°W 59.11' Fence corner

Ratified by Peer Group
 in accordance with P.A. 345

Chairman *Delmar E. Porter*
 Date December 7, 1993

*Witness tags and nails used.

Signed by Ronald R. Bischer Date 12-13-93
 Surveyor's Michigan License No. 22428

CORNER HISTORY RESEARCH SHEET

LIBER 307 PAGE 931

G-5 Corner, Section 9,10,15&16, Township 34N Range 2E

<u>Activity</u>	<u>Monument & Accessories</u>	<u>Notes</u>
1855 Resurvey Geo. H. Cannon	Set Wood Post 18" Sugar N20°E 30½ links 28" Sugar S12°W 38 links	
1975 Delmar E. Porter #15410	Found 3/4" Pipe Set 3 witnesses. Recorded on Page 82, Land Recordation, August 18, 1975.	
1993 Remonumentation Ronald R. Bischer #22428	Found 3/4" Pipe, raised w/½" Rod and Cap #22428. N46°E 47.06' Fence corner found nail w/tag #15410 S43°E 51.56' Power pole found nail w/tag #15410 N50°W 51.07' Top of telephone cable box N39°W 59.11' Fence Corner set nail w/tag #22428	

#3.