

LAND CORNER RECORDATION CERTIFICATE
Filing Requirement of Act 74, Mich. P.A. 1970

Janet M. Lamb
REGISTER OF DEEDS

For corners in

<u>PRESQUE ISLE</u> (County)	Located In:	Corner Code ##
1. Public Land Survey	T <u>34N</u> R <u>2E</u>	<u>G-7</u>
	T _____ R _____	_____
	T _____ R _____	_____
	T _____ R _____	_____
2. Property Controlling in Section	S _____ T _____ R _____	_____
	S _____ T _____ R _____	_____
3. Miscellaneous Property in Sec.	S _____ T _____ R _____	_____
	S _____ T _____ R _____	_____

LIBER **307** PAGE **934**

Register of Deeds Stamp & File Number

4. Lot No. _____, Recorded Plat _____
5. Private Claims _____

	A	B	C	D	E	F	G	H	I	J	K	L
2	6	5	4	3	2							
3												
4	7	8	9	10	11	12						
5												
6	18	17	16	15	14	13						
7												
8	19	20	21	22	23	24						
9												
10	30	29	28	27	26	25						
11												
12	31	32	33	34	35	36						
13												

I, Ronald R. Bischer, in a field survey on September 14, 19 93, do hereby certify that under requirements of P.A. 74, Michigan P.A. of 1970, the corner points mentioned in lines 1 and 2 above were in conformance with regulations and rules therefore as required in the current manual of survey instructions of the United States Department of the Interior, Bureau of Land Management or by a decree of a Court of Law and/or that the corner points mentioned in lines 3, 4 and 5 above were in conformance with the rules of the Michigan Board of Land Surveyors or by a Decree of a Court of Law; established, re-established, monumented, re-monumented, recovered, found as expressed below:

NOTE: Not more than 4 corners, all in the same town and range, may be recorded on this certificate.

A. Description of original monument and accessories and/or subsequent restoration:

G-7
 1855 Resurvey - Geo. H. Cannon (July)
 Set Wood Post N43°W 46.17' Power pole
 13" Cedar N25°W 19 links N48°E 47.67' Fence corner
 14" Cedar S75°E 27½ links Recorded on Page 84, Land
 1975 - Delmar E. Porter Recordation, August 18, 1975.
 Set ½" Rod and Cap #15410 at
 road intersection


B. Description of corner evidence found and/or method applied in restoring or reestablishing corner:

G-7
 Found ½" Rod and Cap #15410 in Monument Box
 N46°W 46.17' Power pole
 N45°E 48.13' Fence corner

SURVEY &
REMONUMENTATION

1993

COMMISSION

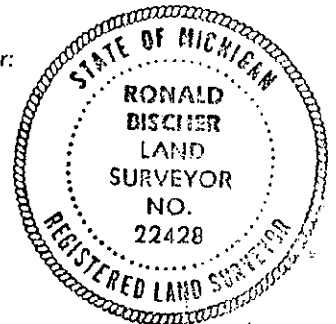

C. Description of monument for corner and accessories established to perpetuate locating the position of the corner:

G-7
 ½" Rod and Cap #15410 in Monument Box
 N46°W 46.17' Power pole
 N45°E 48.13' Fence corner
 N18°W 57.07' Stop sign
 S26°E 40.49' Stop sign

Ratified by Peer Group
in accordance with P.A. 345

Chairman *Delmar E. Porter*
Date December 7, 1993

*Witness tags and nails used.

Signed by Ronald R. Bischer

Date 12-13-93

Surveyor's Michigan License No. 22428

CORNER HISTORY RESEARCH SHEET

LIBER 307 PAGE 935

G-7 Corner, Section 15, 16, 21 & 22, Township 34N Range 2E

<u>Activity</u>	<u>Monument & Accessories</u>	<u>Notes</u>
1855 Resurvey Geo. H. Cannon	Set Wood Post 13" Cedar N25°W 19 links 14" Cedar S75°E 27½ links	:
1975 Delmar E. Porter #15410	Set ½" Rod & Cap #15410 at road intersection Set two witnesses. Recorded on Page 84, Land Recordation, August 18, 1975	
1993 Remonumentation Ronald R. Bischer #22428	Found ½" Rod & Cap #15410 in Monument Box. N46°W 46.17' Power pole found nail w/tag #15410 N45°E 48.13' Fence corner found nail w/tag #15410 N18°W 57.07' Stop Sign (new witness) S26°E 40.49' Stop Sign (new witness)	

#3.