

COMMISSION

1993

PRESQUE ISLE COUNTY
RECORDED

93 DEC 22 AM 10:03

LAND CORNER RECORDATION CERTIFICATE
Filing Requirement of Act 74, Mich. P.A. 1970

Janet M. Lamb
REGISTER OF DEEDS

For corners in

<u>Presque Isle</u> <small>(County)</small>	Located In:	Corner Code #
1. Public Land Survey	T <u>34N</u> R <u>2E</u>	<u>G-9</u>
	T _____ R _____	_____
	T _____ R _____	_____
	T _____ R _____	_____
2. Property Controlling in Section	S _____ T _____ R _____	_____
	S _____ T _____ R _____	_____
3. Miscellaneous Property in Sec.	S _____ T _____ R _____	_____
	S _____ T _____ R _____	_____

Register of Deeds Stamp & File Number

4. Lot No. _____, Recorded Plat _____
 5. Private Claims _____

A	B	C	D	E	F	G	H	I	J	K	L	M
2	6	5	4	3	2	1						
3												
4	7	8	9	10	11	12						
5												
6	16	17	15	15	14	13						
7												
8	19	20	21	22	23	24						
9												
10	30	29	28	27	26	25						
11												
12	31	32	33	34	35	36						
13												

I, DELMER E. PORTER in a field survey on SEPT. 12, 19 93, do hereby certify that under requirements of P.A. 74, Michigan P.A. of 1970, the corner points mentioned in lines 1 and 2 above were in conformance with regulations and rules therefore as required in the current manual of survey instructions of the United States Department of the Interior, Bureau of Land Management or by a decree of a Court of Law and/or that the corner points mentioned in lines 3, 4 and 5 above were in conformance with the rules of the Michigan Board of Land Surveyors or by a Decree of a Court of Law; established, re-established, monumented, re-monumented, recovered, found as expressed below:

NOTE: Not more than 4 corners, all in the same town and range, may be recorded on this certificate.

A. Description of original monument and accessories and/or subsequent restoration:

G-9 GLO NOTES
 JULY 13, 1855
 Y. BIRCH 10" N 50° W 25½ lks.
 CEDAR 7" S 50° E 28 lks.

G-9 P.A. 74 FILING BY DELMER E. PORTER
 L.S. #15410, APRIL 20, 1976 PAGE 116
 LAND CORNER RECORDS
 FOUND 2" ANGLE IRON AS TESTIFIED BY AREA
 RESIDENT RAISED WITH ½" ROD & CAP #15410
 N 62° W 75.84' POWER POLE
 S 60° W 82.28' 6" CEDAR
 S 68° E 50.46' 14" W. PONE


B. Description of corner evidence found and/or method applied in restoring or reestablishing corner:

G-9
 sept. 12, 1993
 FOUND ½" ROD AND CAP #15410
 N 62° W. 75.84' POWER POLE

Ratified by Peer Group
 in accordance with P.A. 345
 Chairman Delmer E. Porter
 Date December 18, 1993

C. Description of monument for corner and accessories established to perpetuate locating the position of the corner:

G-9
 ½" ROD & CAP #15410
 N 01° E 68.78' 5" LYNN
 N 65° E 42.27' 12" ASPEN
 S 24° E 64.17' 5" BALSAM
 S 74° W 73.94' 4" BALSAM
 * NAILS AND TAGS #15410 USED IN WITNESSES
 PORTER'S SURVEY, P.C.

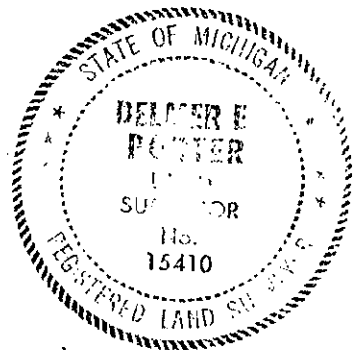

Signed by Delmer E. Porter
 Surveyor's Michigan License No. 15410

Date Dec 20, 1993

CORNER HISTORY RESEARCH SHEET

G-9

T34N,R2E ALLIS TOWNSHIP-NORTH PART,
PRESQUE ISLE COUNTY, MICHIGAN.

ACTIVITY MONUMENT & ACCESSORIES - COMMENTS

GLO Survey
July 13, 1855

Y. Birch 10" N50°W 25 1/2 Links
Cedar 7" S50°E 28 Links

Act 74 filing by:
Delmer E. Porter,
#15410, Apr. 20, 1976,
Page 116, Corner
Recordation

Fd. 2" Angle Iron as described
by area resident, 3' down
in old road bed in line
w/fence to the North
Raised w/ 1/2" Rod & Cap #15410
N62°W 75.84' P. Pole
S60°W 82.28' 6" Cedar
S60°E 50.46' 14" W. Pine

Remonumentation
Sept. 12, 1993

Fd. 1/2" Rod & Cap #15410
N62°W 75.84' P. Pole
Left Same
N01°E 68.78' 5" Lynn
S65°E 42.27' 12" Aspen
S24°E 64.17' 5" Balsam
S74°W 73.94' 4" Balsam

~~3~~