

1993

COMMISSION

PRESQUE ISLE COUNTY
RECORDED

93 DEC 22 AM 10:03

LAND CORNER RECORDATION CERTIFICATE
Filing Requirement of Act 74, Mich. P.A. 1970

Janet M. Lamb
REGISTER OF DEEDS

For corners in

| | | |
|--|-------------------------|---------------|
| <u>PRESQUE ISLE</u> <small>(County)</small> | Located In: | Corner Code # |
| 1. Public Land Survey | T <u>34N</u> <u>02E</u> | <u>G-10</u> |
| | T _____ R _____ | _____ |
| | T _____ R _____ | _____ |
| | T _____ R _____ | _____ |
| 2. Property Controlling in Section | S _____ T _____ R _____ | _____ |
| | S _____ T _____ R _____ | _____ |
| 3. Miscellaneous Property in Sec. | S _____ T _____ R _____ | _____ |
| | S _____ T _____ R _____ | _____ |

Register of Deeds Stamp & File Number

- 4. Lot No. _____, Recorded Plat _____
- 5. Private Claims _____

| A | B | C | D | E | F | G | H | I | J | K | L |
|----|----|----|----|----|----|----|---|---|---|---|---|
| 2 | 6 | 5 | 4 | 3 | 2 | 1 | | | | | |
| 3 | | | | | | | | | | | |
| 4 | 7 | 8 | 9 | 10 | 11 | 12 | | | | | |
| 5 | | | | | | | | | | | |
| 6 | 18 | 17 | 16 | 15 | 14 | 13 | | | | | |
| 7 | | | | | | | | | | | |
| 8 | 19 | 20 | 21 | 22 | 23 | 24 | | | | | |
| 9 | | | | | | | | | | | |
| 10 | 30 | 29 | 28 | 27 | 26 | 25 | | | | | |
| 11 | | | | | | | | | | | |
| 12 | 31 | 32 | 33 | 34 | 35 | 36 | | | | | |
| 13 | | | | | | | | | | | |

I, DELMER E. PORTER a field survey on DEC. 9, 19 93, do hereby certify that under requirements of P.A. 74, Michigan P.A. of 1970, the corner points mentioned in lines 1 and 2 above were in conformance with regulations and rules therefore as required in the current manual of survey instructions of the United States Department of the Interior, Bureau of Land Management or by a decree of a Court of Law and/or that the corner points mentioned in lines 3, 4 and 5 above were in conformance with the rules of the Michigan Board of Land Surveyors or by a Decree of a Court of Law; established, re-established, monumented, re-monumented, recovered, found as expressed below:

NOTE: Not more than 4 corners, all in the same town and range, may be recorded on this certificate.

A. Description of original monument and accessories and/or subsequent restoration:

G-10 GLO NOTES
JULY 13, 1855
CEDAR 14" N 33° E 19 lks.
LYNN 12" S 20° W 25 lks.

G-10 P.A. 74 FILING BY DELMER E. PORTER
L.S. #15410 APRIL 20, 1976 PAGE 117
LAND CORNER RECORDS
SET 1/2" ROD & CAP #15410 BY SINGLE PROPORTIONS 12' EAST OF N-S FENCE
S 22° E 103.6' FENCE CORNER
N 70° W 26.08' 9" BIRCH
S 20° E 26.99' 18" SPRUCE
S 65° W 26.34' 10" BIRCH


B. Description of corner evidence found and/or method applied in restoring or reestablishing corner:

G-10
DEC. 9, 1993
FOUND 1/2" ROD & CAP #15410
S 65° W 26.50' 10" BIRCH
N 63° W 26.23' 9" BIRCH

Ratified by Peer Group
in accordance with P.A. 345
Chairman *Delmer E. Porter*
Date December 18, 1993

C. Description of monument for corner and accessories established to perpetuate locating the position of the corner:

G-10
1/2" ROD & CAP #15410
S 10° E 27.25' 18" SPRUCE
S 65° W 26.50' 10" BIRCH
N 63° W 26.23' 9" Birch
N 33° E 28.25' 12" ASPEN
* NAILS AND TAGS #15410 USED IN WITNESSES
PORTER'S SURVEY, P.C.

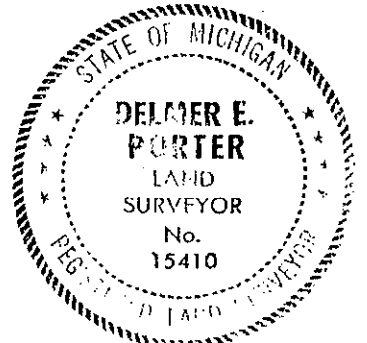

Signed by *Delmer E. Porter*
Surveyor's Michigan License No. 15410

Date Dec 20, 1993

CORNER HISTORY RESEARCH SHEET

G-10

_____, T34N,R2E ALLIS TOWNSHIP-NORTH PART,
PRESQUE ISLE COUNTY, MICHIGAN.

ACTIVITY MONUMENT & ACCESSORIES - COMMENTS

GLO Survey
July 13, 1855

Cedar 14" N33°E 19 Links
Lynn 12" S20°W 25 Links

Act 74 Filing By
Delmer E. Porter #15410
April 20, 1976, Page 117
Corner Recordation

Set 1/2" Rod & Cap #15410
by single proportion
12' East of N-S Fence
S21°48'37"E 103.6' FE Cor.
N70°W 26.08' 9" Birch
S20°E 26.99' 18" Spruce
S65°W 26.34' 10" Birch

P.I. Remonumentation
Dec. 9, 1993

Fd. 1/2" Rod & Cap #15410
and all witnesses above
S10°E 27.25' 18" Spruce
S65°W 26.50' 10" Birch
N63°W 26.23' 9" Birch
N33°E 28.25' 12" Aspen

#5