

1993

PRESQUE ISLE COUNTY
RECORDED

93 DEC 22 AM 10:03

COMMISSION

LAND CORNER RECORDATION CERTIFICATE

Filing Requirement of Act 74, Mich. P.A. 1970

Janet M. Lamb
REGISTER OF DEEDS

For corners in

| | | |
|------------------------------------|--------------------------|---------------|
| <u>PRESQUE ISLE</u> (County) | Located In: | Corner Code # |
| 1. Public Land Survey | T <u>34N</u> R <u>2E</u> | <u>G-11</u> |
| | T _____ R _____ | _____ |
| | T _____ R _____ | _____ |
| | T _____ R _____ | _____ |
| 2. Property Controlling in Section | S _____ T _____ R _____ | _____ |
| | S _____ T _____ R _____ | _____ |
| 3. Miscellaneous Property in Sec. | S _____ T _____ R _____ | _____ |
| | S _____ T _____ R _____ | _____ |

Register of Deeds Stamp & File Number

- 4. Lot No. _____, Recorded Plat _____
- 5. Private Claims _____

| A | B | C | D | E | F | G | H | I | J | K | L | M |
|----|----|----|----|----|----|----|---|---|---|---|---|---|
| 2 | 6 | 5 | 4 | 3 | 2 | 1 | | | | | | |
| 3 | | | | | | | | | | | | |
| 4 | 7 | 8 | 9 | 10 | 11 | 12 | | | | | | |
| 5 | | | | | | | | | | | | |
| 6 | 18 | 17 | 16 | 15 | 14 | 13 | | | | | | |
| 7 | | | | | | | | | | | | |
| 8 | 19 | 20 | 21 | 22 | 23 | 24 | | | | | | |
| 9 | | | | | | | | | | | | |
| 10 | 30 | 29 | 28 | 27 | 26 | 25 | | | | | | |
| 11 | | | | | | | | | | | | |
| 12 | 31 | 32 | 33 | 34 | 35 | 36 | | | | | | |

I, DELMER E. PORTER in a field survey on DEC. 9, 1993, do hereby certify that under requirements of P.A. 74, Michigan P.A. of 1970, the corner points mentioned in lines 1 and 2 above were in conformance with regulations and rules therefore as required in the current manual of survey instructions of the United States Department of the Interior, Bureau of Land Management or by a decree of a Court of Law and/or that the corner points mentioned in lines 3, 4 and 5 above were in conformance with the rules of the Michigan Board of Land Surveyors or by a Decree of a Court of Law; established, re-established, monumented, re-monumented, recovered, found as expressed below:

NOTE: Not more than 4 corners, all in the same town and range, may be recorded on this certificate.

A. Description of original monument and accessories and/or subsequent restoration:

G-11 GLO NOTES
 JULY 13, 1855
 HEMLOCK 14" S 28° W 14 lks.
 HEMLOCK 14" N 75° E 48 lks.

WITNESSES WEST 0.72' WEST GATE POST
 EAST 17.32' EAST GATE POST
 SOUTH 93.73' FENCE POST
 G-11 P.A. 74 FILING BY DELMER E. PORTER
 L.S. #15410 NOV. 6, 1978, PAGE 386
 LAND CORNER RECORDS. REPLACED 1/2" ROD & C
 WITH 4" CONCRETE MONUMENT WITH BRASS CA
 SAME WITNESSES AS ABOVE

G-11
 P.A. 74 FILING BY DELMER E. PORTER
 L.S. #15410 APRIL 20, 1976, PAGE 117
 LAND CORNER RECORDS


B. Description of corner evidence found and/or method applied in restoring or reestablishing corner:

G-11
 DEC. 9, 1993
 FOUND 4" CONCRETE MONUMENT WITH BRASS CAP
 ALL WITNESSES IN POOR CONDITION

Ratified by Peer Group
 in accordance with P.A. 345
 Chairman *Delmer E. Porter*
 Date December 18, 1993

C. Description of monument for corner and accessories established to perpetuate locating the position of the corner:

G-11
 4" CONCRETE MONUMENT WITH BRASS CAP
 S 25° E 82.75' 3" WHITE PINE
 S 40° W 54.46' 3" WHITE PINE
 S 88° W 98.43' 4" WHITE PINE
 N 05° E 96.00' 4" TAMARACK
 * NAILS AND TAGS #15410 USED ON WITNESSES
 PORTER'S SURVEY, P.C.

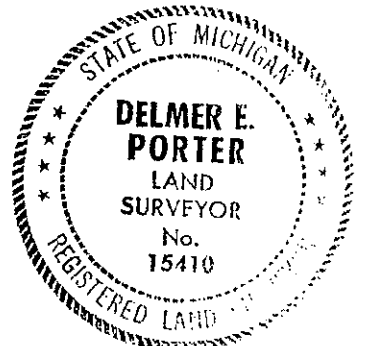

Signed by *Delmer E. Porter*
 Surveyor's Michigan License No. 15410

Date Dec 20, 1993

CORNER HISTORY RESEARCH SHEET

G-11

T34N,R2E ALLIS TOWNSHIP-NORTH PART,
PRESQUE ISLE COUNTY, MICHIGAN.

ACTIVITY MONUMENT & ACCESSORIES COMMENTS

GLO Survey
July 13, 1855

Hemlock 14" S28°W 14 Links
Hemlock 14" N75°E 48 Links

Act 74 filing by
Delmer E. Porter #15410
April 20, 1976, Page 117
Corner Recordation

Found old square stake
at Fence Corner
Replaced w/1/2" Rod & Cap #15410
Due West 0.72' West Gate Post
Due East 17.32' East Gate Post
Due South 93.73' FE Post

Act 74 filing by
Delmer E. Porter #15410
Nov. 6, 1978, Page 386
Corner Recordation

Found 1/2" Rod & Cap #15410
Due West 0.72' Gate Post
Due East 17.32' Gate Post Presque Isle
Due South 93.73' FE Post County
Replaced w/P.I. Co. Remon. Remon.
Conc. Mon. & Brass Cap Project
Same Witnesses

Presque Isle
Remonumentation
Dec. 9, 1993

Fd. Conc. Mon. w/ brass cap
and same witness as above
All witnesses in poor condition,
replaced
S25°E 82.75' 3" W. Pine
S40°W 54.46' 3" W. Pine
S88°W 98.43' 4" W. Pine
N05°E 96.00' 4" Tamarack

41
A/