

1993

COMMISSION

LAND CORNER RECORDATION CERTIFICATE
Filing Requirement of Act 74, Mich. P.A. 1970

PRESQUE ISLE COUNTY
RECORDED

93 DEC 22 AM 10:03

Janet M. Lamb
REGISTER OF DEEDS

For corners in

<u>PRESQUE ISLE</u> <small>(County)</small>	Located In:	Corner Code #/
1. Public Land Survey	T <u>34</u> N R <u>2</u> E	G-12
	T _____ R _____	_____
	T _____ R _____	_____
	T _____ R _____	_____
2. Property Controlling in Section	S _____ T _____ R _____	_____
	S _____ T _____ R _____	_____
3. Miscellaneous Property in Sec.	S _____ T _____ R _____	_____
	S _____ T _____ R _____	_____

Register of Deeds Stamp & File Number

4. Lot No. _____, Recorded Plat _____
5. Private Claims _____

	A	B	C	D	E	F	G	H	I	J	K	L
2	6	5	4	3	2	1						
3												
4	7	8	9	10	11	12						
5												
6	16	17	16	15	14	13						
7												
8	19	20	21	22	23	24						
9												
10	30	29	28	27	26	25						
11												
12	31	32	33	34	35	36						
13												

I, DELMER E. PORTER with a field survey on SEPT. 13, 19 93, do hereby certify that under requirements of P.A. 74, Michigan P.A. of 1970, the corner points mentioned in lines 1 and 2 above were in conformance with regulations and rules therefore as required in the current manual of survey instructions of the United States Department of the Interior, Bureau of Land Management or by a decree of a Court of Law and/or that the corner points mentioned in lines 3, 4 and 5 above were in conformance with the rules of the Michigan Board of Land Surveyors or by a Decree of a Court of Law; established, re-established, monumented, re-monumented, recovered, found as expressed below:

NOTE: Not more than 4 corners, all in the same town and range, may be recorded on this certificate.

A. Description of original monument and accessories and/or subsequent restoration:

G-12 GLO NOTES
JULY 13, 1855
Y. BIRCH 10" S 22° E 26 lks.
Y. BIRCH 10" N 81° W 27 lks.

G-12 P.A. 74 FILING BY DELMER E. PORTER
L.S. #15410 APRIL 20, 1976, PAGE 117
LAND CORNER RECORDS
FOUND 1/2" ROD
N 05° E 34.00' FENCE CORNER
S 88° E 34.90' FENCE CORNER
S 25° W 23.69' TELEPHONE CABLE MARKER


B. Description of corner evidence found and/or method applied in restoring or reestablishing corner:

G-12
SEPT. 13, 1993
FOUND 1/2" ROD & CAP #15410
N 43° W 42.33' 8" APPLE
S 24° W 23.43' TELEPHONE CABLE MARKER
(FROM UNRECORDED SURVEY #115-87 - PORTER'S SURVEY, P.C.)

Ratified by Peer Group
in accordance with P.A. 345
Chairman *Delmer E. Porter*
Date December 18, 1993

C. Description of monument for corner and accessories established to perpetuate locating the position of the corner:

G-12
1/2" ROD AND CAP #15410
N 43° W 42.33' 8" APPLE
N 55° E 44.65' 5" ASPEN
S 60° E 69.69' 6" ASPEN
S 36° W 95.50' 11" ASPEN
* NAILS AND TAGS #15410 USED ON WITNESSES
PORTER'S SURVEY, P.C.

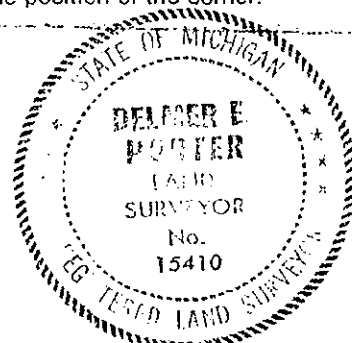

Signed by *Delmer E. Porter*
Surveyor's Michigan License No. 15410

Date Dec 20, 1993

CORNER HISTORY RESEARCH SHEET

G-12

T34N,R2E ALLIS TOWNSHIP-NORTH PART,
PRESQUE ISLE COUNTY, MICHIGAN.

ACTIVITY MONUMENT & ACCESSORIES - COMMENTS

GLO Survey
July 13, 1855

Y. Birch 10" S22°E 26 Links
Y. Birch 10" N81°W 27 Links

Survey by:
Porter's Survey,
#15410, Feb.14, 1970

Fd. 1/2" Rod
Same as above

Act 74 filing by:
Delmer E. Porter,
#15410, April 20, 1976,
Page 117, Corner
Recordation

Fd. 1/2" Rod
Left Same
N05°E 34.00' Fe. Cor.
S88°E 34.90' Fe. Cor.
S25°W 23.69' Telephone Cable Marker

Act 132 Survey by:
Porter's Survey,
#15410, Aug.11, 1983,
Survey#82-83
File#34R2136
Lib. 252, Pg. 252

Same as above

Act 132 Survey by:
Porter's Survey,
#15410, Dec.22, 1989,
Survey#115-87

1/2" Rod & RLS Cap #15410
Fd. S24°W 23.43' Face Tel. Riser
S24°E 30.93' 4" W. Birch (New)
N43°W 42.23' 6" Apple (New)

Remonumentation
Sept. 13, 1993

Fd. 1/2" Rod & Cap #15410
N43°W 42.33' 8" Apple
Left Same
N43°W 42.33' 8" Apple
N55°E 44.65' 5" Aspen
S60°E 69.69' 6" Aspen
S36°W 95.50' 11" Aspen

h
K