

1993

COMMISSION

LAND CORNER RECORDATION CERTIFICATE
Filing Requirement of Act 74, Mich. P.A. 1970

PRESQUE ISLE COUNTY
RECORDED

93 DEC 22 AM 10:03

Janet M. Lamb
REGISTER OF DEEDS

For corners in

PRESQUE ISLE
(County)

Located In:

Corner Code 11

- | | | | | | |
|------------------------------------|---|------------|---|-----------|-------------|
| 1. Public Land Survey | T | <u>34N</u> | R | <u>2E</u> | <u>G-13</u> |
| | T | _____ | R | _____ | _____ |
| | T | _____ | R | _____ | _____ |
| | T | _____ | R | _____ | _____ |
| 2. Property Controlling in Section | S | _____ | T | _____ | _____ |
| | S | _____ | T | _____ | _____ |
| 3. Miscellaneous Property in Sec. | S | _____ | T | _____ | _____ |
| | S | _____ | T | _____ | _____ |

Register of Deeds Stamp & File Number

4. Lot No. _____, Recorded Plat _____
5. Private Claims _____

I, DELMER E. PORTER in a field survey on SEPT. 13, 19 93, do hereby certify that under requirements of P.A. 74, Michigan P.A. of 1970, the corner points mentioned in lines 1 and 2 above were in conformance with regulations and rules therefore as required in the current manual of survey instructions of the United States Department of the Interior, Bureau of Land Management or by a decree of a Court of Law and/or that the corner points mentioned in lines 3, 4 and 5 above were in conformance with the rules of the Michigan Board of Land Surveyors or by a Decree of a Court of Law; established, re-established, monumented, re-monumented, recovered, found as expressed below:

NOTE: Not more than 4 corners, all in the same town and range, may be recorded on this certificate.

A	B	C	D	E	F	G	H	I	J	K	L
2	6	5	4	3	2	1					
3											
4	7	8	9	10	11	12					
5											
6	18	17	16	15	14	13					
7											
8	19	20	21	22	23	24					
9											
10	30	29	28	27	26	25					
11											
12	31	32	33	34	35	36					
13											


- A. Description of original monument and accessories and/or subsequent restoration:
- G-13 GLO NOTES WITNESSES
 JULY 13, 1855 N 40° W 51.56' 12" WHITE PINE
 CEDAR 8" S 42° E 21 lks. S 65° W 53.95' 10" CEDAR
 WHITE PINE 10" S 56° W 20 lks. S 35° E 51.08' 6" CEDAR

G-13 P.A. 74 FILING BY DELMER E. PORTER L.S #15410 NOV. 6, 1978, PAGE 386
 L.S. #15410 APRIL 20, 1976 LAND CORNER RECORDS. REPLACED 1 1/2" PIPE
 PAGE 116, LAND CORNER RECORDS WITH 4" CONCRETE MONUMENT
 FOUND 1 1/2" PIPE IN FENCE LINE WEST AND WITNESSES SAME AS ABOVE
 ROAD CENTERLINE EAST & WEST

- B. Description of corner evidence found and/or method applied in restoring or reestablishing corner:
- G-13
 SEPT. 13, 1993
 FOUND CONCRETE MONUMENT WITH BRASS CAP - 4"
 N 32° W 51.52' 21" WHITE PINE

Ratified by Peer Group
 in accordance with P.A. 805
 Chairman *Delmer E. Porter*
 Date December 18, 1993

- C. Description of monument for corner and accessories established to perpetuate locating the position of the corner:
- G-13
 4" CONCRETE MONUMENT WITH BRASS CAP
 N 32° W 51.52' 21" WHITE PINE
 S 79° E 22.18' 4" ASPEN
 S 12° E 36.18' 6" CEDAR
 S 43° W 70.63' 9" CEDAR
 * NAILS AND TAGS #15410 USED ON WITNESSES
 PORTER'S SURVEY, P.C.

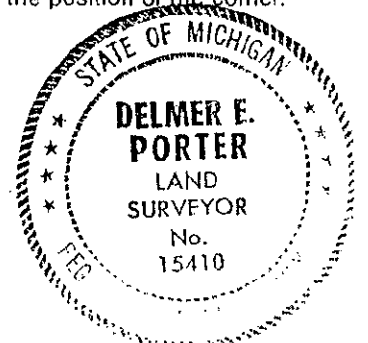

Signed by *Delmer E. Porter*
 Surveyor's Michigan License No. 15410

Date Dec 20, 1993

CORNER HISTORY RESEARCH SHEET

G-13

T34N,R2E ALLIS TOWNSHIP-NORTH PART,
PRESQUE ISLE COUNTY, MICHIGAN.

ACTIVITY	MONUMENT & ACCESSORIES	COMMENTS
GLO Survey July 3, 1855	Cedar 8" S42°E 21 Links White Pine 10" S56°W 20 Links	
Section Survey Fd. Aug. 29, 1973 Recorded Apr. 20, 1976	Fd. 1 1/4" Pipe in line w/ Fe. Line to West & Road Centerline East & West	
Act 74 filing by: Delmer E. Porter, #15410, April 20, 1976, Page 116, Corner Recordation	Fd. 1 1/4" Pipe in line w/ Fe. Line to West & Road Centerline East & West Left Same N40°W 51.56' 12" White Pine S65°W 53.95' 10" Cedar S35°E 51.08' 6" Cedar	
Act 74 filing by: Delmer E. Porter, #15140, Nov. 6, 1978, Page 386, Corner Recordation	Fd. 1 1/4" Pipe N40°W 51.52' 12" W. Pine S65°W 53.95' 10" Cedar S35°E 51.08' 6" Cedar Replaced w/ P.I. Co. Remon. Conc. Mon. & Brass Cap Same Witnesses	Presque Isle County Remonumentation Project
Act 132 Survey by: Delmer E. Porter, #15410, May 4, 1989 Survey#25-89 File#34R2217 Unrecorded	Fd. 4" Conc. Mon. and Same Witnesses	
Remonumentation Sept. 13, 1993	Fd. Conc. Mon. w/ P.I. Co. Remon. Brass Cap N32°W 51.52' 21" W. Pine Left Same N32°W 51.52' 21" W. Pine S79°E 22.18' 4" Aspen S12°E 36.18' 6" Cedar S43°W 70.63' 9" Cedar	

X/31