

93 DEC 20 PM 4: 50

LAND CORNER RECORDATION CERTIFICATE  
Filing Requirement of Act 74, Mich. P.A. 1970

*Jenice M. Lamb*  
REGISTER OF DEEDS

For corners in

PRESQUE ISLE  
(County)

Located In:

Corner Code #

- |                                    |   |            |   |           |            |
|------------------------------------|---|------------|---|-----------|------------|
| 1. Public Land Survey              | T | <u>34N</u> | R | <u>2E</u> | <u>H-1</u> |
|                                    | T | _____      | R | _____     | _____      |
|                                    | T | _____      | R | _____     | _____      |
|                                    | T | _____      | R | _____     | _____      |
| 2. Property Controlling in Section | S | _____      | T | _____     | _____      |
|                                    | S | _____      | T | _____     | _____      |
| 3. Miscellaneous Property in Sec.  | S | _____      | T | _____     | _____      |
|                                    | S | _____      | T | _____     | _____      |

LIBER **307** PAGE **936**

Register of Deeds Stamp & File Number

4. Lot No. \_\_\_\_\_, Recorded Plat \_\_\_\_\_
5. Private Claims \_\_\_\_\_

A	B	C	D	E	F	G	H	I	J	K	L	M
2	6	5	4	3	2	1						
3												
4	7	8	9	10	11	12						
5												
6	18	17	16	15	14	13						
7												
8	19	20	21	22	23	24						
9												
10	30	29	28	27	26	25						
11												
12	31	32	33	34	35	36						
13												

I, Ronald R. Bischer, in a field survey on September 14, 19 93, do hereby certify that under requirements of P.A. 74, Michigan P.A. of 1970, the corner points mentioned in lines 1 and 2 above were in conformance with regulations and rules therefore as required in the current manual of survey instructions of the United States Department of the Interior, Bureau of Land Management or by a decree of a Court of Law and/or that the corner points mentioned in lines 3, 4 and 5 above were in conformance with the rules of the Michigan Board of Land Surveyors or by a Decree of a Court of Law; established, re-established, monumented, re-monumented, recovered, found as expressed below:

NOTE: Not more than 4 corners, all in the same town and range, may be recorded on this certificate.

A. Description of original monument and accessories and/or subsequent restoration:

H-1  
 Corner not set in Original Survey 1978 - Delmar E. Porter (Remonumentation)  
 1977 - Ronald R. Bischer Set Concrete Monument by single  
 Found 1" Bar set by David Bowen proportion and from witnesses from 1977.  
 N06°E 101.96' 5" Lynn (Not recorded)  
 N06°W 74.78' 6" Ash  
 N65°E 69.15' 6" Elm  
 Recorded on Page 201, Land  
 Recordation, October 19, 1977.


B. Description of corner evidence found and/or method applied in restoring or reestablishing corner:

H-1  
 Found Presque Isle County Remonumentation Monument  
 N16°E 101.96' 10" Lynn  
 N01°W 74.78' 10" Ash

SURVEY &  
REMONUMENTATION

1993

COMMISSION

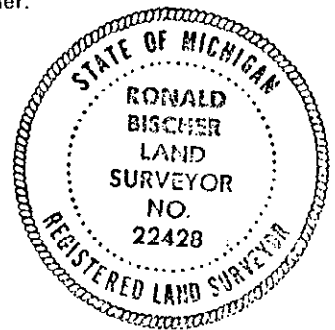

C. Description of monument for corner and accessories established to perpetuate locating the position of the corner:

H-1  
 Presque Isle County Remonumentation Monument  
 N16°E 101.96' 10" Lynn  
 N01°W 74.78' 10" Ash  
 S38°W 73.56' 6" Apple tree  
 S84°E 27.83' 8" Elm  
 N63°W 54.92' 12" Ash

Ratified by Peer Group  
 in accordance with P.A. 345  
 Chairman *Delmar E. Porter*  
 Date December 7, 1993

\*Witness tags and nails used.

Signed by Ronald R. Bischer

Date 12-13-93

Surveyor's Michigan License No. 22428

H-1 Corner, Section 3, Township 34N Range 2E

<u>Activity</u>	<u>Monument &amp; Accessories</u>	<u>Notes</u>
Corner not set in Original Survey		
1977 Ronald R. Bischer #22428	Found 1" Bar Set 3 witnesses Recorded on Page 201, Land Recordation, October 19, 1977.	1" Bar set by David Bowen at an unknown date.
1978 Delmar E. Porter #15410	Set Concrete Monument w/Brass Cap from witnesses, could not find 1" Bar. (farmer working field) (Not recorded)	
1993 Remonumentation Ronald R. Bischer #22428	Found Concrete Monument w/Brass Cap N16°E 101.96' 10" Lynn found nail w/tag #15410 N01°W 74.78' 10" Ash found nail w/tag #15410 S38°W 73.56' 6" Apple Tree set nail w/tag #22428 S84°E 27.83' 8" Elm set nail w/tag #22428 N63°W 54.92' 12" Ash set nail w/tag #22428	

45.