

LAND CORNER RECORDATION CERTIFICATE
Filing Requirement of Act 74, Mich. P.A. 1970

For corners in

<u>PRESQUE ISLE</u> <small>(County)</small>	Located In:	Corner Code #
1. Public Land Survey	T <u>34N</u> R <u>2E</u>	<u>H-5</u>
	T _____ R _____	_____
	T _____ R _____	_____
	T _____ R _____	_____
2. Property Controlling in Section	S _____ T _____ R _____	_____
	S _____ T _____ R _____	_____
3. Miscellaneous Property in Sec.	S _____ T _____ R _____	_____
	S _____ T _____ R _____	_____

Just M. Lamb
REGISTER OF DEEDS

LIBER 307 PAGE 940

Register of Deeds Stamp & File Number

4. Lot No. _____, Recorded Plat _____
5. Private Claims _____

I, Ronald R. Bischer, in a field survey on September 15, 19 93, do hereby certify that under requirements of P.A. 74, Michigan P.A. of 1970, the corner points mentioned in lines 1 and 2 above were in conformance with regulations and rules therefore as required in the current manual of survey instructions of the United States Department of the Interior, Bureau of Land Management or by a decree of a Court of Law and/or that the corner points mentioned in lines 3, 4 and 5 above were in conformance with the rules of the Michigan Board of Land Surveyors or by a Decree of a Court of Law; established, re-established, monumented, re-monumented, recovered, found as expressed below:

NOTE: Not more than 4 corners, all in the same town and range, may be recorded on this certificate.

	A	B	C	D	E	F	G	H	I	J	K	L	M
2	6		5		4		3		2		1		
3													
4	7		8		9		10		11		12		
5								●					
6	18		17		16		15		14		13		
7													
8	19		20		21		22		23		24		
9													
10	30		29		28		27		26		25		
11													
12	31		32		33		34		35		36		
13													


A. Description of original monument and accessories and/or subsequent restoration:

- H-5
1855 Resurvey - Geo. H. Cannon (July) N02°E 33.88' Fence corner
Set Wood Post S14°W 31.77' 5" Apple tree
26" Sugar N45°E 28 links Recorded on Page 84, Land
20" Sugar S09°E 14 links Recordation, August 18, 1975.
1975 - Delmar E. Porter
Set 1/2" Rod and Cap #15410
N53°E 94.75' 3" Scotch pine

B. Description of corner evidence found and/or method applied in restoring or reestablishing corner:

- H-5
1/2" Rod and Cap #15410
N53°E 94.53' 14" Scotch Pine
Due N 34.88' Fence corner
S14°W 31.77' 8" Apple tree

SURVEY &
REMONUMENTATION
1993
COMMISSION

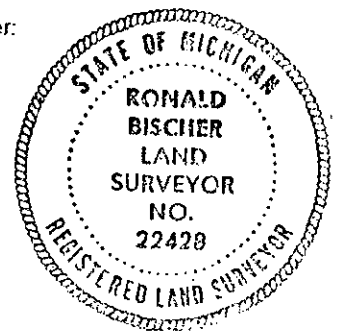

C. Description of monument for corner and accessories established to perpetuate locating the position of the corner:

- H-5
1/2" Rod and Cap #15410
N53°E 94.53' 14" Scotch pine
Due N 34.88' Fence corner
S14°W 31.77' 8" Apple tree
N29°E 58.62' 4" Scotch pine

Ratified by Peer Group
in accordance with P.A. 345
Chairman *Delmar E. Porter*
Date December 7, 1993

*Witness tags and nails used.

Signed by Ronald R. Bischer Date 12-13-93
Surveyor's Michigan License No. 22428

H-5 Corner, Section 3, 10, Township 34N Range 2E

<u>Activity</u>	<u>Monument & Accessories</u>	<u>Notes</u>
1855 Resurvey Geo. H. Cannon	Set Wood Post 26" Sugar N45°E 28 links 20" Sugar S09°E 14 links	
1975 Delmar E. Porter #15410	Set ½" Rod & Cap #15410 Set three witnesses. Recorded on Page 84, Land Recordation, August 18, 1975.	Set corner in road centerline in line with fences running North & South.
1993 Remonumentation Ronald R. Bischer #22428	Found ½" Rod & Cap #15410 N53°E 94.53' 14" Scotch Pine set nail w/tag #22428 in scarred area where previous tag was probably located. North 34.88' Fence corner found nail w/tag #15410 S14°W 31.77' 8" Apple Tree found nail w/tag #15410 N29°E 58.62' 4" Scotch Pine set nail w/tag #22428	

#5.