

1993

PRESQUE ISLE COUNTY
RECORDED

93 DEC 22 AM 10:03

COMMISSION

LAND CORNER RECORDATION CERTIFICATE
Filing Requirement of Act 74, Mich. P.A. 1970

Janet M. Lamb
REGISTER OF DEEDS

For corners in

<u>PRESQUE ISLE</u> <small>(County)</small>	Located In:	Corner Code #
1. Public Land Survey	T <u>34</u> N <u>2</u> E	<u>H-9</u>
	T _____ R _____	_____
	T _____ R _____	_____
	T _____ R _____	_____
2. Property Controlling in Section	S _____ T _____ R _____	_____
	S _____ T _____ R _____	_____
3. Miscellaneous Property in Sec.	S _____ T _____ R _____	_____
	S _____ T _____ R _____	_____

Register of Deeds Stamp & File Number

- 4. Lot No. _____, Recorded Plat _____
- 5. Private Claims _____

A	B	C	D	E	F	G	H	I	J	K	L
2	6	5	4	3	2						
3											
4	7	8	9	10	11						
5											
6	18	17	16	15	14						
7											
8	19	20	21	22	23	2					
9											
10	30	29	28	27	26	2					
11											
12	31	32	33	34	35	3					
13											

I, DELMER E. PORTER a field survey on SEPT. 13, 1993, do hereby certify that under requirements of P.A. 74, Michigan P.A. of 1970, the corner points mentioned in lines 1 and 2 above were in conformance with regulations and rules therefore as required in the current manual of survey instructions of the United States Department of the Interior, Bureau of Land Management or by a decree of a Court of Law and/or that the corner points mentioned in lines 3, 4 and 5 above were in conformance with the rules of the Michigan Board of Land Surveyors or by a Decree of a Court of Law; established, re-established, monumented, re-monumented, recovered, found as expressed below:

NOTE: Not more than 4 corners, all in the same town and range, may be recorded on this certificate.

A. Description of original monument and accessories and/or subsequent restoration:

H-9 GLO NOTES
JULY 13, 1855
CEDAR 11" S 36° W 13 lks.
Y. BIRCH 14" N 23° E 23 lks.

WITNESSES
NORTH 32.54' FENCE CORNER
SOUTH 32.53' FENCE CORNER
S 50° E 46.02' P. POLE

H-9
P.A. 74 FILING BY DELMER E. PORTER
L.S. #15410 APRIL 20, 1976 PAGE 115
LAND CORNER RECORDS, SET 1/2" ROD & CAP #15410
FROM ESTABLISHED FENCE CORNERS


B. Description of corner evidence found and/or method applied in restoring or reestablishing corner:

H-9
SEPT. 13, 1993
FOUND 1/2" ROD & CAP #15410
NO WITNESSES

Ratified by Peer Group
in accordance with P.A. 345
Chairman *Delmer E. Porter*
Date *December 18, 1993*

C. Description of monument for corner and accessories established to perpetuate locating the position of the corner:

H-9
1/2" ROD & CAP #15410
S 08° W 31.13' P. POLE #0N1-18-36
S 11° W 174.21 6" APPLE
S 74° W 172.88' 6" APPLE
N 75° W 214.54' 8" ELM
* NAILS AND TAGS #15410 USED ON WITNESSES
PORTER'S SURVEY, P.C.

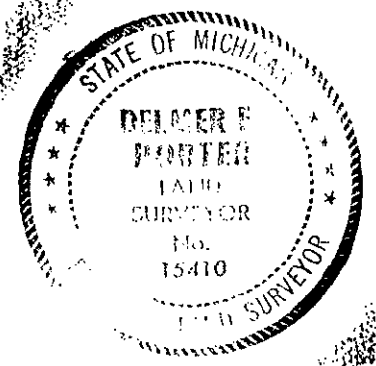

Signed by *Delmer E. Porter*
Surveyor's Michigan License No. 15410

Date *Dec 20, 1993*

CORNER HISTORY RESEARCH SHEET

H-9

T34N,R2E ALLIS TOWNSHIP-NORTH PART,
PRESQUE ISLE COUNTY, MICHIGAN.

ACTIVITY MONUMENT & ACCESSORIES - COMMENTS

GLO Survey
July 13, 1855

Cedar 11" S36°W 13 Links
Y. Birch 14" N23°E 23 Links

Porter's Survey
Set 1/2" Rod &
Cap #15410,
July 5, 1972

1/2" Rod & Cap #15410
Set from Established
Fence Corners North &
South

Act 74 filing by:
Delmer E. Porter,
#15410, Apr.20, 1976
Page 115, Corner
Recordation

Set 1/2" Rod & Cap #15410
From Established Fence Cor.
Due North 32.54' Fe. Cor.
Due South 32.53' Fe. Cor.
S50°E 46.02' P. Pole

Act 132 Survey by;
Delmer E. Porter
#15410, Feb.2, 1977,
Survey#6-77,
File#34R2086
Lib.216, Pg.404

Same as Recorded 1976
Page 115

Remonumentation
Sept. 13, 1993

Fd. 1/2" Rod & Cap #15410
Left Same
S08°W 31.13' P. Pole # on 1-18-36
S11°W 174.21' 6" Apple
S74°W 172.88' 6" Apple
N75°W 214.54' 8" Elm

#5

RECORDATION
JAN 22 2001
SECTION