

1993

PRESQUE ISLE COUNTY
RECORDED

93 DEC 22 AM 10:03

COMMISSION

LAND CORNER RECORDATION CERTIFICATE
Filing Requirement of Act 74, Mich. P.A. 1970

John M. Lamb
REGISTER OF DEEDS

For corners in

<u>PRESQUE ISLE</u> (County)	Located In:	Corner Code #
1. Public Land Survey	T <u>34N</u> R <u>2E</u>	<u>H-11</u>
	T _____ R _____	_____
	T _____ R _____	_____
	T _____ R _____	_____
2. Property Controlling in Section	S _____ T _____ R _____	_____
	S _____ T _____ R _____	_____
3. Miscellaneous Property in Sec.	S _____ T _____ R _____	_____
	S _____ T _____ R _____	_____

Register of Deeds Stamp & File Number

- 4. Lot No. _____, Recorded Plat _____
- 5. Private Claims _____

I, DELMER E. PORTER in a field survey on DEC. 8, 19 93, do hereby certify that under requirements of P.A. 74, Michigan P.A. of 1970, the corner points mentioned in lines 1 and 2 above were in conformance with regulations and rules therefore as required in the current manual of survey instructions of the United States Department of the Interior, Bureau of Land Management or by a decree of a Court of Law and/or that the corner points mentioned in lines 3, 4 and 5 above were in conformance with the rules of the Michigan Board of Land Surveyors or by a Decree of a Court of Law; established, re-established, monumented, re-monumented, recovered, found as expressed below:

NOTE: Not more than 4 corners, all in the same town and range, may be recorded on this certificate.

A. Description of original monument and accessories and/or subsequent restoration:

H-11 GLO NOTES
JULY 13, 1855
CEDAR 14" S 50° E 6lks.
CEDAR 11" N 18° W 27½ lks.

H-11 P.A. 74 FILING BY DELMER E. PORTER
#15410 APRIL 20, 1976 PAGE 115
LAND CORNER RECORDS
SET ½" ROD & CAP #15410 BY
SINGLE PROPORTION

WITNESSES

N 60° W 46.56' 9" ELM
S 75° W 27.02' 13" ELM
S 40° W 42.62' 12" ASPEN
H-11 P.A. 74 FILING BY DELMER E. P
L.S #15410 NOV. 6, 1978 PAGE 386
LAND CORNER RECORDS. REPLACED ½" R
& CAP WITH 4" CONCRETE MONUMENT WI
BRASS CAP, WITNESSES SAME AS ABOVE

B. Description of corner evidence found and/or method applied in restoring or reestablishing corner:


H-11
DEC. 8, 1993
FOUND 4" CONCRETE MONUMENT WITH BRASS CAP
S 40° W 42.62' 12" ASPEN (STUMP)

C. Description of monument for corner and accessories established to perpetuate locating the position of the corner:

H-11
4" CONCRETE MONUMENT WITH BRASS CAP
N 59° W 19.88' 6" ELM
S 43° W 31.00' 6" ASPEN
S 18° W 27.82' 5" ASPEN
N 88° E 36.33' 6" ASPEN
* NAILS AND TAGS #15410 USED ON WITNESSES
PORTER'S SURVEY, P.C.

Ratified by Peer Group
in accordance with P.A. 345

Chairman *Delmer E. Porter*
Date December 18, 1993

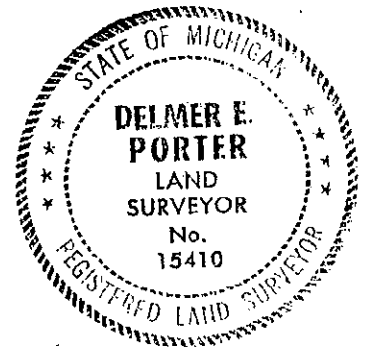

Signed by *Delmer E. Porter*

Date Dec 20, 1993

Surveyor's Michigan License No. 15410

CORNER HISTORY RESEARCH SHEET

H-11

T34N,R2E ALLIS TOWNSHIP--NORTH PART,
PRESQUE ISLE COUNTY, MICHIGAN.

ACTIVITY	MONUMENT & ACCESSORIES	COMMENTS
----------	------------------------	----------

GLO Survey
July 13, 1855

Cedar 14" S50°E 6 Links
Cedar 11" N18°W 27 1/2 Links

Act 74 Filing by
Delmer E. Porter #15410
April 20, 1976, Page 115
Corner Recordation

Set 1/2" Rod & Cap #15410
by single proportion
N60°W 46.56' 9" Elm
S75°W 27.02' 13" Elm
S40°W 42.62' 12" Aspen

Act 74 filing by
Delmer E. Porter #15410
Nov. 6, 1978, Page 386
Corner Recordation

Found 1/2" Rod & Cap #15410
N60°W 46.56' 9" Elm
S75° 27.02' 13" Elm
S40°W 42.62' 12" Aspen
Replaced w/P.I. Co.
Remon.
Conc. Mon. & Brass Cap
Same Witness

Presque Isle
County
Remon.
Project

Presque Isle
Remonumentation
Dec. 8, 1993

FD. Conc. Mon. with brass cap
and blazed 12" Aspen stump
N59°W 19.88' 6" Elm
S43°W 31.00' 6" Aspen
S18°W 27.82' 5" Aspen
N88°E 36.33' 6" Aspen

15/