

93 DEC 22 AM 10:03

1993

LAND CORNER RECORDATION CERTIFICATE
Filing Requirement of Act 74, Mich. P.A. 1970

Janet M. Lamb
REGISTER OF DEEDS

COMMISSION
For corners in
PRESQUE ISLE
(County)

	Located In:	Corner Code #
1. Public Land Survey	T <u>34N</u> <u>2E</u>	<u>H-13</u>
	T _____ R _____	_____
	T _____ R _____	_____
	T _____ R _____	_____
2. Property Controlling in Section	S _____ T _____ R _____	_____
	S _____ T _____ R _____	_____
3. Miscellaneous Property in Sec.	S _____ T _____ R _____	_____
	S _____ T _____ R _____	_____

Register of Deeds Stamp & File Number

4. Lot No. _____, Recorded Plat _____
5. Private Claims _____

	A	B	C	D	E	F	G	H	I	J	K	L
2	6		5		4		3		2		1	
3												
4	7		8		9		10		11		12	
5												
6	18		17		16		15		14		13	
7												
8	19		20		21		22		23		24	
9												
10	30		29		28		27		26		25	
11												
12	31		32		33		34		35		36	
13												

I, DELEMER E. PORTER a field survey on SEPT. 13, 19 93, do hereby certify that under requirements of P.A. 74, Michigan P.A. of 1970, the corner points mentioned in lines 1 and 2 above were in conformance with regulations and rules therefore as required in the current manual of survey instructions of the United States Department of the Interior, Bureau of Land Management or by a decree of a Court of Law and/or that the corner points mentioned in lines 3, 4 and 5 above were in conformance with the rules of the Michigan Board of Land Surveyors or by a Decree of a Court of Law; established, re-established, monumented, re-monumented, recovered, found as expressed below:

NOTE: Not more than 4 corners, all in the same town and range, may be recorded on this certificate.

A. Description of original monument and accessories and/or subsequent restoration:

H-13 GLO NOTES

JULY 3, 1855

ASPEN 16" N 54° E 14lks.

SUGAR 7" N 26° W 9 lks.

H-13 PA 74 FILING BY RONALD R. BISCHER

L.S.#22428, SEPT. 9, 1981, PAGE 569

LAND CORNER RECORDS

SET 1/2" ROD & CAP #15410 BY SINGLE PROPORTION.

N 04°W 59.95' 10" APPLE N 20°E 51.47' FE. COR.

N 55° E 95.75' 28" LYNN

H-13 PA 74 FILING BY NORMAN J. QUAIN. LS #33984 MAY 8, PAGE 773, LAND CORNER RECORDS FND 1/2" ROD & CAP #15410 IN CORNER SINGLE PROPORTION POSITION, HOWEVER, WITNESSES DID NOT FIND AS REPORTED. N 04°W 62.15' 10" N58°E 98.45' 28" LYNN APPLIED S 29°E 62.72' 8" J. PINE

B. Description of corner evidence found and/or method applied in restoring or reestablishing corner:

H-13

SEPT. 13, 1993

FOUND 1/2" ROD & CAP #15410

N 57° E 95.89' 30" LYNN

Ratified by Peer Group
in accordance with P.A. 345

Chairman *Delmer E. Porter*

Date *December 18, 1993*

C. Description of monument for corner and accessories established to perpetuate locating the position of the corner:

H-13

1/2" ROD & CAP #15410

N 11° E 76.62' 12" LYNN


N 57° E 95.89' 30" LYNN

S 38° E 79.40' 5" SCOTCH PINE

S 49° W 59.00' 3" CEDAR

* NAILS AND TAGS #15410 USED ON WITNESSES

PORTER'S SURVEY, P.C.

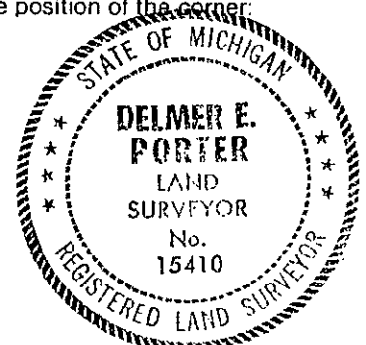

Signed by *Delmer E. Porter*

Date *Dec 20, 1993*

Surveyor's Michigan License No. 15410

CORNER HISTORY RESEARCH SHEET

H-13

T34N,R2E ALLIS TOWNSHIP-NORTH PART,
PRESQUE ISLE COUNTY, MICHIGAN.

ACTIVITY MONUMENT & ACCESSORIES - COMMENTS

GLO Survey
July 3, 1855

Aspen 16" N54°E 14 Links
Sugar 7" N26°W 9 Links

Act 74 filing by:
Ronald R. Bischer,
#22428, Sept. 9, 1981
Page 569, Corner
Recordation

Set 1/2" Rod by
Single Proportion
N04°W 59.95' 10" Apple
N20°E 51.47' Fe. Cor.
N55°E 95.75' 28" Lynn

Act 74 filing by:
Norman J. Quaine,
#33984, May 8, 1989,
Page 773, Corner
Recordation

Fd. 1/2" Rod & Cap #15410
in proper position but
Witnesses appear to be incorrect.
Left Same
N04°W 62.15' 12" Apple
N58°E 98.45' 28" Lynn
S29°E 62.72' 8" J. Pine

Remonumentation
Sept. 13, 1993

Fd. 1/2" Rod & Cap #15410
N57°E 95.89' 30" Lynn
Left Same
N11°E 76.62' 12" Lynn
N57°E 95.89' 30" Lynn
S38°E 79.40' 5" Scotch Pine
S49°W 59.00' 3" Cedar

#5

JAN 22 2001

SECTION