

PRESQUE ISLE COUNTY
RECORDED

93 DEC 20 PM 4:50

Janet M. Lamb
REGISTER OF DEEDS

LAND CORNER RECORDATION CERTIFICATE
Filing Requirement of Act 74, Mich. P.A. 1970

For corners in

PRESQUE ISLE
(County)

Located In:

Corner Code #

- | | | | | | |
|------------------------------------|---|------------|---|-----------|------------|
| 1. Public Land Survey | T | <u>34N</u> | R | <u>2E</u> | <u>I-1</u> |
| | T | _____ | R | _____ | _____ |
| | T | _____ | R | _____ | _____ |
| | T | _____ | R | _____ | _____ |
| 2. Property Controlling in Section | S | _____ | T | _____ | _____ |
| | S | _____ | T | _____ | _____ |
| 3. Miscellaneous Property in Sec. | S | _____ | T | _____ | _____ |
| | S | _____ | T | _____ | _____ |

LIGER 307 PAGE 944

Register of Deeds Stamp & File Number

4. Lot No. _____, Recorded Plat _____
5. Private Claims _____

I, Ronald R. Bischer, in a field survey on September 15, 19 93, do hereby certify that under requirements of P.A. 74, Michigan P.A. of 1970, the corner points mentioned in lines 1 and 2 above were in conformance with regulations and rules therefore as required in the current manual of survey instructions of the United States Department of the Interior, Bureau of Land Management or by a decree of a Court of Law and/or that the corner points mentioned in lines 3, 4 and 5 above were in conformance with the rules of the Michigan Board of Land Surveyors or by a Decree of a Court of Law; established, re-established, monumented, re-monumented, recovered, found as expressed below:

NOTE: Not more than 4 corners, all in the same town and range, may be recorded on this certificate.

A	B	C	D	E	F	G	H	I	J	K	L	M
2	6		5		4		3		2		1	
3												
4	7		8		9		10		11		12	
5												
6	18		17		16		15		14		13	
7												
8	19		20		21		22		23		24	
9												
10	30		29		28		27		26		25	
11												
12	31		32		33		34		35		36	
13												

A. Description of original monument and accessories and/or subsequent restoration:

- I-1
1855 Resurvey - Geo. H. Cannon (July) Recorded on Page 201, Land
Set Wood Post Recordation, October 19, 1977.
8" Beech S58°E 83 links 1978 - Delmar E. Porter (Remonumentation)
18" Hemlock S35°W 20 links Replaced 1" Bar with Concrete Monument
1977 - Ronald R. Bischer w/Brass Cap, used 1977 Bischer witnesses.
Found 1" Bar by David Bowen (Not recorded)
S53°E 9.19' 4" Scotch pine
S10°E 14.57' 4" Scotch pine


B. Description of corner evidence found and/or method applied in restoring or reestablishing corner:

- I-1
Found Presque Isle County Remonumentation Monument
S53°E 9.19' 6" Scotch pine
S14°E 14.57' 6" Scotch pine

SURVEY &
REMONUMENTATION

1993

COMMISSION

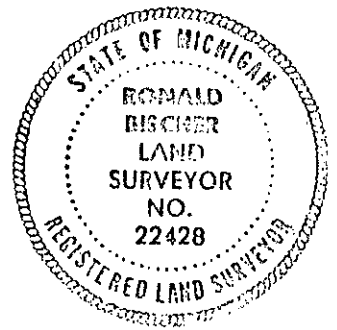

C. Description of monument for corner and accessories established to perpetuate locating the position of the corner:

- I-1
Presque Isle County Remonumentation Monument
S53°E 9.19' 6" Scotch pine
S14°E 14.57' 6" Scotch pine
S47°E 64.19' 8" Norway pine
N33°W 58.38' 6" Aspen

Ratified by Peer Group
in accordance with P.A. 345

Chairman *Delmar E. Porter*
Date December 7, 1993

*Witness tags and nails used.

Signed by Ronald R. Bischer Date 12-13-93
Surveyor's Michigan License No. 22428

I-1 Corner, Section 2, 3, Township 34N Range 2E

<u>Activity</u>	<u>Monument & Accessories</u>	<u>Notes</u>
1855 Resurvey Geo. H. Cannon	Set Wood Post 8" Beech S58°E 83 links 18" Hemlock S35°W 20 links	
1977 Ronald R. Bischer #22428	Found 1" Bar Set two witnesses. Recorded on Page 201, Land Reocrdation, October 19, 1977	David Bowen set 1" Bar at an unknown date.
1978 Remonumentation Delmar E. Porter #15410	Replaced 1" Bar with Concrete Monument w/Brass Cap Two witnesses. (Not recorded)	
1993 Remonumentation Ronald R. Bischer #22428	Concrete Monument w/Brass Cap S53°E 9.19' 6" Scotch Pine found nail w/tag #15410 S14°E 14.57' 6" Scotch Pine found nail w/tag #15410 S47°E 64.19' 8" Norway Pine set nail w/tag #22428 N33°W 58.38' 6" Aspen set nail w/tag #22428	

#3