

93 DEC 20 PM 4: 50

LAND CORNER RECORDATION CERTIFICATE
Filing Requirement of Act 74, Mich. P.A. 1970

Janet M. Lamb
REGISTER OF DEEDS

For corners in

PRESQUE ISLE
(County)

Located In:

Corner Code #

- 1. Public Land Survey T 34N R 2E I-4
 T _____ R _____
 T _____ R _____
 T _____ R _____
- 2. Property Controlling S _____ T _____ R _____
 in Section S _____ T _____ R _____
- 3. Miscellaneous S _____ T _____ R _____
 Property in Sec. S _____ T _____ R _____

LIBER **307** PAGE **950**

Register of Deeds Stamp & File Number

- 4. Lot No. _____, Recorded Plat _____
- 5. Private Claims _____

	A	B	C	D	E	F	G	H	I	J	K	L	M
2	6	5	4	3	2								
3													
4	7	8	9	10	11	12							
5													
6	18	17	16	15	14	13							
7													
8	19	20	21	22	23	24							
9													
10	30	29	28	27	26	25							
11													
12	31	32	33	34	35	36							
13													

I, Ronald R. Bischer, in a field survey on September 20, 19 93, do hereby certify that under requirements of P.A. 74, Michigan P.A. of 1970, the corner points mentioned in lines 1 and 2 above were in conformance with regulations and rules therefore as required in the current manual of survey instructions of the United States Department of the Interior, Bureau of Land Management or by a decree of a Court of Law and/or that the corner points mentioned in lines 3, 4 and 5 above were in conformance with the rules of the Michigan Board of Land Surveyors or by a Decree of a Court of Law; established, re-established, monumented, re-monumented, recovered, found as expressed below:

NOTE: Not more than 4 corners, all in the same town and range, may be recorded on this certificate.

A. Description of original monument and accessories and/or subsequent restoration:

- I-4
 1855 Resurvey - Geo. H. Cannon (July) location.
 Set Wood Post 1992 - Norman J. Quaine
 15" Beech S45°W 9 links Reset ½" Rod and Cap #15410
 16" Sugar N25°E 5 links N60°W 15.42' 24" Lynn
 1989 - Norman J. Quaine N07°W 13.34' 12" Maple
 Set ½" Rod & Cap by single N78°E 21.48' 12" Maple
 proportion, and four witnesses. S12°E 19.24' 12" Birch
 Corner found to be in the wrong (Not recorded)


B. Description of corner evidence found and/or method applied in restoring or reestablishing corner:

- I-4
 ½" Rod and Cap #15410 found
 N60°W 15.42' 24" Lynn
 N07°W 13.34' 12" Maple
 N78°E 21.48' 12" Maple
 S12°E 19.24' 12" Birch

SURVEY &
REMONUMENTATION

1993

COMMISSION

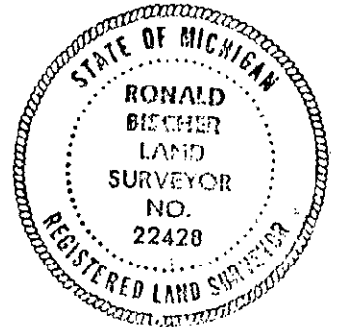

C. Description of monument for corner and accessories established to perpetuate locating the position of the corner:

- I-4
 ½" Rod and Cap #15410
 N60°W 15.42' 24" Lynn
 N07°W 13.34' 12" Maple
 N78°E 21.48' 12" Maple
 S12°E 19.24' 12" Birch

Ratified by Peer Group
in accordance with P.A. 345

Chairman *Delmer E. Pata*

Date December 7, 1993

*Witness tags and nails used.

Signed by Ronald R. Bischer

Date 12-13-93

Surveyor's Michigan License No. 22428

I-4 Corner, Section 10, 11, Township 34N Range 2E

<u>Activity</u>	<u>Monument & Accessories</u>	<u>Notes</u>
1855 Resurvey Geo. H. Cannon	Set Wood Post 15" Beech S45°W 9 links 16" Sugar N25°E 5 links	
1989 Norman J. Quaine #33984	Set ½" Rod & Cap #15410 by single proportion. Set three witnesses. Recorded on Page 776, Land Recordation, November 13, 1989.	
1992 Norman J. Quaine #33984	Reset ½" Rod & Cap #15410 by single proportion Set four witnesses. (Not recorded)	<i>Recorded 1st</i>
1993 Remonumentation Ronald R. Bischer #22428	Found ½" Rod & Cap #15410 N60°W 15.42' 24" Lynn found nail w/tag #15410 N07°W 13.34' 12" Maple found nail w/tag #15410 N78°E 21.48' 12" Maple found nail w/tag #15410 S12°E 19.24' 12" Birch found nail w/tag #15410	