

93 DEC 20 PM 4: 50

LAND CORNER RECORDATION CERTIFICATE  
Filing Requirement of Act 74, Mich. P.A. 1970

*Gene M. Lamb*  
REGISTER OF DEEDS

For corners in

PRESQUE ISLE  
(County)

Located In:

Corner Code #

- |                                    |                          |            |
|------------------------------------|--------------------------|------------|
| 1. Public Land Survey              | T <u>34N</u> R <u>2E</u> | <u>I-5</u> |
|                                    | T _____ R _____          | _____      |
|                                    | T _____ R _____          | _____      |
|                                    | T _____ R _____          | _____      |
| 2. Property Controlling in Section | S _____ T _____ R _____  | _____      |
|                                    | S _____ T _____ R _____  | _____      |
| 3. Miscellaneous Property in Sec.  | S _____ T _____ R _____  | _____      |
|                                    | S _____ T _____ R _____  | _____      |

LIBER **307** PAGE **952**

Register of Deeds Stamp & File Number

4. Lot No. \_\_\_\_\_, Recorded Plat \_\_\_\_\_
5. Private Claims \_\_\_\_\_

|    | A  | B | C  | D | E  | F | G  | H | I  | J | K  | L | M |
|----|----|---|----|---|----|---|----|---|----|---|----|---|---|
| 2  | 6  |   | 5  |   | 4  |   | 3  |   | 2  |   | 1  |   |   |
| 3  |    |   |    |   |    |   |    |   |    |   |    |   |   |
| 4  | 7  |   | 8  |   | 9  |   | 10 |   | 11 |   | 12 |   |   |
| 5  |    |   |    |   |    |   |    |   | ●  |   |    |   |   |
| 6  | 18 |   | 17 |   | 16 |   | 15 |   | 14 |   | 13 |   |   |
| 7  |    |   |    |   |    |   |    |   |    |   |    |   |   |
| 8  | 19 |   | 20 |   | 21 |   | 22 |   | 23 |   | 24 |   |   |
| 9  |    |   |    |   |    |   |    |   |    |   |    |   |   |
| 10 | 30 |   | 29 |   | 28 |   | 27 |   | 26 |   | 25 |   |   |
| 11 |    |   |    |   |    |   |    |   |    |   |    |   |   |
| 12 | 31 |   | 32 |   | 33 |   | 34 |   | 35 |   | 36 |   |   |
| 13 |    |   |    |   |    |   |    |   |    |   |    |   |   |

I, Ronald R. Bischer, in a field survey on September 20, 19 93, do hereby certify that under requirements of P.A. 74, Michigan P.A. of 1970, the corner points mentioned in lines 1 and 2 above were in conformance with regulations and rules therefore as required in the current manual of survey instructions of the United States Department of the Interior, Bureau of Land Management or by a decree of a Court of Law and/or that the corner points mentioned in lines 3, 4 and 5 above were in conformance with the rules of the Michigan Board of Land Surveyors or by a Decree of a Court of Law; established, re-established, monumented, re-monumented, recovered, found as expressed below:

**NOTE: Not more than 4 corners, all in the same town and range, may be recorded on this certificate.**

A. Description of original monument and accessories and/or subsequent restoration:

- I-5  
 1855 Resurvey - Geo. H. Cannon (July) S72°W 15.88' 2'x2' gray stone  
 Set Wood Post N71°E 21.87' 2½'x4½' black stone  
 12" Cedar S42°W 45 links Recorded on Page 83, Land  
 20" Cedar N73°E 13 links Recordation, August 18, 1975.  
 1975 - Delmar E. Porter  
 Set ½" Rod and Cap #15410 at fence corner  
 N74°W 24.49' 3'x2' large red stone


B. Description of corner evidence found and/or method applied in restoring or reestablishing corner:

- I-5  
 Found ½" Rod and Cap #15410 at fence corner  
 N74°W 24.49' 3'x2' Red stone  
 Other witness stones appear to have been moved by road construction.

SURVEY &  
REMONUMENTATION

1993

COMMISSION

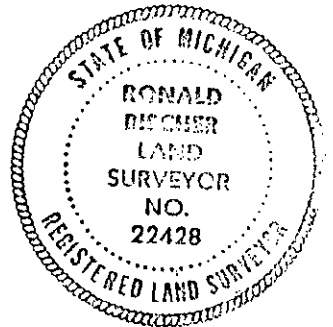

C. Description of monument for corner and accessories established to perpetuate locating the position of the corner:

- I-5  
 ½" Rod and Cap #15410 at fence corner  
 N74°W 24.49' 3'x2' Red stone  
 N38°E 8.00' 2½'x4½' Black stone  
 N45°W 103.40' 4" White pine  
 N85°W 1.55' Fence corner

Ratified by Peer Group  
in accordance with P.A. 345

Chairman *Delmar E. Porter*

Date December 7, 1993

\*Witness tags and nails used.

Signed by Ronald R. Bischer

Date 12-17-93

Surveyor's Michigan License No. 22428

## CORNER HISTORY RESEARCH SHEET

LIBER 307 PAGE 953

I-5 Corner, Section 10,11,14&15 Township 34N Range 2E

| <u>Activity</u>                                     | <u>Monument &amp; Accessories</u>   | <u>Notes</u> |
|---|---|--------------|
| 1855 Resurvey<br>Geo. H. Cannon                     | Set Wood Post<br>12" Cedar S42°W 45 links<br>20" Cedar N73°E 13 links   | :            |
| 1975<br>Delmar E. Porter<br>#15410                  | Set ½" Rod & Cap #15410<br>at fence corner<br>Set three witnesses   |              |
| 1993 Remonumentation<br>Ronald R. Bischer<br>#22428 | Found ½" Rod & Cap #15410<br>N74°W 24.49' 3'x2' Red stone<br>N38°E 8.00' 2½'x4½' Black stone<br>N45°W 103.40' 4" White Pine<br>set nail w/tag #22428<br>N85°W 1.55' Fence corner<br>set nail w/tag #22428 |              |

#5  
—