

LAND CORNER RECORDATION CERTIFICATE 93 DEC 20 PM 4: 50
Filing Requirement of Act 74, Mich. P.A. 1970

For corners in

PRESQUE ISLE
(County)

Located In:

Corner Code -#

- | | | | | | |
|------------------------------------|---|------------|---|-----------|------------|
| 1. Public Land Survey | T | <u>34N</u> | R | <u>2E</u> | <u>I-6</u> |
| | T | _____ | R | _____ | _____ |
| | T | _____ | R | _____ | _____ |
| | T | _____ | R | _____ | _____ |
| 2. Property Controlling in Section | S | _____ | T | _____ | _____ |
| | S | _____ | T | _____ | _____ |
| 3. Miscellaneous Property in Sec. | S | _____ | T | _____ | _____ |
| | S | _____ | T | _____ | _____ |

Janet M. Lamb
REGISTER OF DEEDS

LIBER 307 PAGE 954

Register of Deeds Stamp & File Number

4. Lot No. _____, Recorded Plat _____
5. Private Claims _____

I, Ronald R. Bischer, in a field survey on September 20, 19 93, do hereby certify that under requirements of P.A. 74, Michigan P.A. of 1970, the corner points mentioned in lines 1 and 2 above were in conformance with regulations and rules therefore as required in the current manual of survey instructions of the United States Department of the Interior, Bureau of Land Management or by a decree of a Court of Law and/or that the corner points mentioned in lines 3, 4 and 5 above were in conformance with the rules of the Michigan Board of Land Surveyors or by a Decree of a Court of Law; established, re-established, monumented, re-monumented, recovered, found as expressed below:

NOTE: Not more than 4 corners, all in the same town and range, may be recorded on this certificate.

| | A | B | C | D | E | F | G | H | I | J | K | L | M |
|----|----|---|----|---|----|---|----|---|----|---|----|---|---|
| 2 | 6 | | 5 | | 4 | | 3 | | 2 | | 1 | | |
| 3 | | | | | | | | | | | | | |
| 4 | 7 | | 8 | | 9 | | 10 | | 11 | | 12 | | |
| 5 | | | | | | | | | | | | | |
| 6 | 18 | | 17 | | 16 | | 15 | | 14 | | 13 | | |
| 7 | | | | | | | | | | | | | |
| 8 | 19 | | 20 | | 21 | | 22 | | 23 | | 24 | | |
| 9 | | | | | | | | | | | | | |
| 10 | 30 | | 29 | | 28 | | 27 | | 26 | | 25 | | |
| 11 | | | | | | | | | | | | | |
| 12 | 31 | | 32 | | 33 | | 34 | | 35 | | 36 | | |
| 13 | | | | | | | | | | | | | |

A. Description of original monument and accessories and/or subsequent restoration:

I-6
1855 Resurvey - Geo. H. Cannon (July)
Set Wood Post
10" Sugar N17°E 34 links
12" Beech S21°W 12 links
1975 - Delmar E. Porter
Set 1/2" Rod and Cap #15410 at ~~Point~~
intersection
N40°E 83.82' 7" Aspen

Recorded on Page 83, Land
Recordation, August 18, 1975.
S40°E 99.80' 8" Apple tree
1978 - Delmar E. Porter (Remonumentation)
Found 1/2" Rod & Cap #15410, replaced
with Concrete Monument w/Brass Cap.
Used witnesses from 1975.
Recorded on page 361, Land
Recordation, November 29, 1978.


B. Description of corner evidence found and/or method applied in restoring or reestablishing corner:

I-6
Found Presque Isle County Remonumentation Monument
N46°E 83.82' 10" Aspen
S40°E 99.80' 8" Apple tree

REMONUMENTATION

1993

COMMISSION

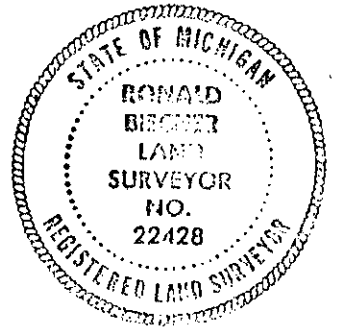

C. Description of monument for corner and accessories established to perpetuate locating the position of the corner:

I-6
Presque Isle County Remonumentation Monument
N46°E 83.82' 10" Aspen
S40°E 99.80' 8" Apple tree
Due W 0.71' Fence corner
S87°E 82.79' 4" Birch

Ratified by Peer Group
in accordance with P.A. 345
Chairman *Delmar E. Porter*
Date December 7, 1993

*Witness tags and nails used.

Signed by Ronald R. Bischer

Date 12-13-93

Surveyor's Michigan License No. 22428

I-6 Corner, Section 14 & 15, Township 34N Range 2E

| <u>Activity</u> | <u>Monument & Accessories</u> | <u>Notes</u> |
|---|---|--------------|
| 1855 Resurvey Geo. H. Cannon | Set Wood Post 10" Sugar N17°E 34 links 12" Beech S21°W 12 links | |
| 1975 Delmar E. Porter #15410 | Set ½" Rod & Cap #15410 at fence intersection Set two witnesses. Recorded on Page 83, Land Recordation, August 18, 1975 | |
| 1978 Remonumentation Delmar E. Porter #15410 | Found ½" Rod & Cap #15410, replaced with Concrete Monument w/Brass Cap Two witnesses. Recorded on Page 361, Land Recordation, November 29, 1978. | |
| 1993 Remonumentation Ronald R. Bischer #22428 | Found Concrete Monument w/Brass Cap N46°E 83.82' 10" Aspen found nail w/tag #15410 S40°E 99.80' 8" Apple Tree found nail w/tag #15410 West 0.71' Fence corner set nail w/tag #22428 S87°E 82.79' 4" Birch set nail w/tag #22428 | |