

PRESQUE ISLE COUNTY
RECORDED

93 DEC 20 PM 4:50

LAND CORNER RECORDATION CERTIFICATE
Filing Requirement of Act 74, Mich. P.A. 1970

Janet M. Lamb
REGISTER OF DEEDS

For corners in

PRESQUE ISLE
(County)

Located In:

Corner Code #

- | | | | | | |
|------------------------------------|---|------------|---|-----------|------------|
| 1. Public Land Survey | T | <u>34N</u> | R | <u>2E</u> | <u>I-7</u> |
| | T | _____ | R | _____ | _____ |
| | T | _____ | R | _____ | _____ |
| | T | _____ | R | _____ | _____ |
| 2. Property Controlling in Section | S | _____ | T | _____ | _____ |
| | S | _____ | T | _____ | _____ |
| 3. Miscellaneous Property in Sec. | S | _____ | T | _____ | _____ |
| | S | _____ | T | _____ | _____ |

LIBER **307** PAGE **956**

Register of Deeds Stamp & File Number

4. Lot No. _____, Recorded Plat _____
5. Private Claims _____

I, Ronald R. Bischer, in a field survey on September 20, 19 93, do hereby certify that under requirements of P.A. 74, Michigan P.A. of 1970, the corner points mentioned in lines 1 and 2 above were in conformance with regulations and rules therefore as required in the current manual of survey instructions of the United States Department of the Interior, Bureau of Land Management or by a decree of a Court of Law and/or that the corner points mentioned in lines 3, 4 and 5 above were in conformance with the rules of the Michigan Board of Land Surveyors or by a Decree of a Court of Law; established, re-established, monumented, re-monumented, recovered, found as expressed below:

A	B	C	D	E	F	G	H	I	J	K	L	M
2	6	5	4	3	2	1						
3												
4	7	8	9	10	11	12						
5												
6	18	17	16	15	14	13						
7												
8	19	20	21	22	23	24						
9												
10	30	29	28	27	26	25						
11												
12	31	32	33	34	35	36						
13												

NOTE: Not more than 4 corners, all in the same town and range, may be recorded on this certificate.

A. Description of original monument and accessories and/or subsequent restoration:

I-7

1855 Resurvey - Geo. H. Cannon (July)

Set Wood Post

28" Sugar S61°W 42 links

24" Sugar N39°E 37½ links

1975 - Delmar E. Porter

Found "T" Iron, raised with ½" Rod and cap #15410, set monument box.

N01°E 40.96' Power pole

S44°E 62.19' 6" Apple tree

S36°W 56.83' 4" Apple tree

Recorded on Page 83, Land Recordation, 9/18/75.

1978 - Delmar E. Porter - Found ½" Rod

and Cap in Monument Box

N02°E 41.00' Power pole

S38°E 61.88' 12" Apple tree

S38°W 75.72' 8" Maple

(Recorded on Page 252, Land Recordation, 9/29/78)

B. Description of corner evidence found and/or method applied in restoring or reestablishing corner:

I-7

Found ½" Rod in Monument Box

N01°E 40.96' Power pole


S37°E 62.19' 6" Apple tree

Set Cap #22428 on ½" Rod.

SUBCOMMISSIONER

1993

COMMISSIONER

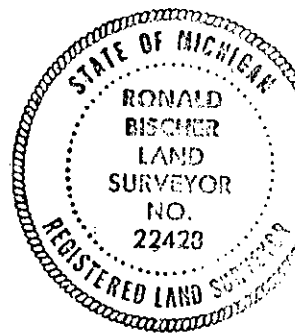

C. Description of monument for corner and accessories established to perpetuate locating the position of the corner:

I-7

½" Rod and Cap #22428 in Monument Box

N01°E 40.96' Power pole

S37°E 62.19' 6" Apple tree

S57°W 62.33' 12" Maple

S03°W 33.06' Fence corner

*Witness tags and nails used.

Ratified by Peer Group
in accordance with P.A. 345

Chairman *Delmar E. Porter*

Date December 7, 1993

Signed by Ronald R. Bischer

Date 12-13-93

Surveyor's Michigan License No. 22428

CORNER HISTORY RESEARCH SHEET

LIBER 307 PAGE 957

I-7 Corner, Section 14,15,22&23 Township 34N Range 2E

<u>Activity</u>	<u>Monument & Accessories</u>	<u>Notes</u>
1855 Resurvey Geo. H. Cannon	Set Wood Post 28" Sugar S61°W 42 links 24" Sugar N39°E 37½" links	
1978 Delmar E. Porter #15410	Found ½" Rod & Cap #15410 in Mon. Box Set three witnesses. Recorded on Page 252, Land Recordation, September 29, 1978.	1977 - found "T" Iron raised w/½" Rod & Cap. (Porter)
1993 Remonumentation Ronald R. Bischer #22428	Found ½" Rod in Monument Box, (No Cap), set cap #22428 N01°E 40.96' Power pole found nail w/tag #15410 S37°E 62.19' 6" Apple Tree found nail w/tag #15410 S57°W 62.33' 12" Maple set nail w/tag #22428 S03°W 33.06' Fence corner set nail w/tag #22428	

#3,